


T. 4 S. R. 1 W. W. M.

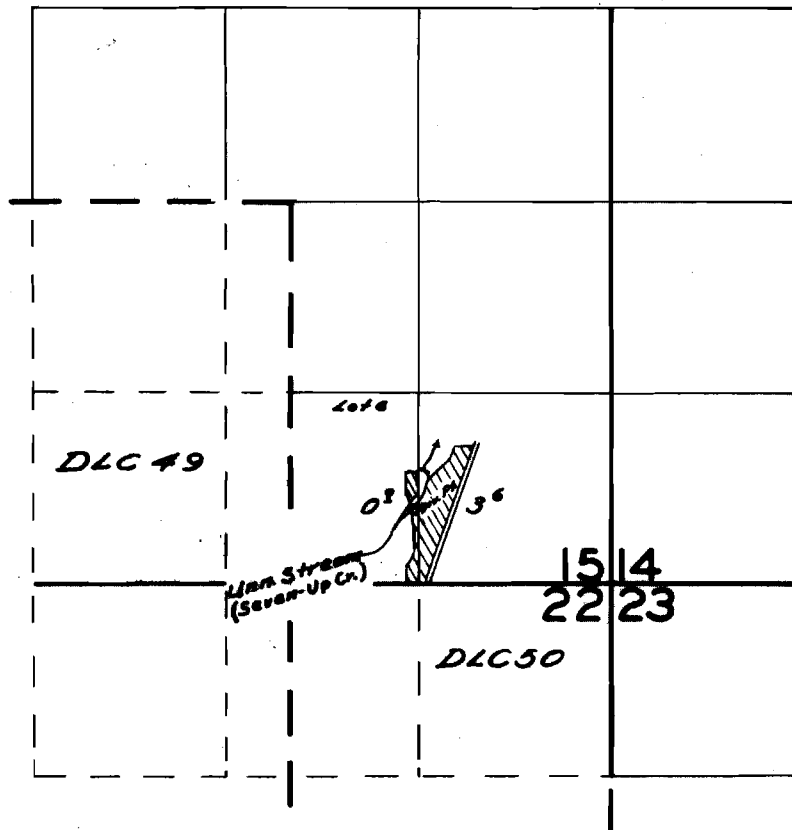

**FINAL PROOF SURVEY**

UNDER

Application No. *R-25165* *R-1074*  
*25166* Permit No. *12722*....

IN NAME OF

*Richard H. & Clara Pearl Pence*....

Surveyed *June 1* 1956, by *C. D. Bartels*