


T. 6 S. R. 1 W. W. M.

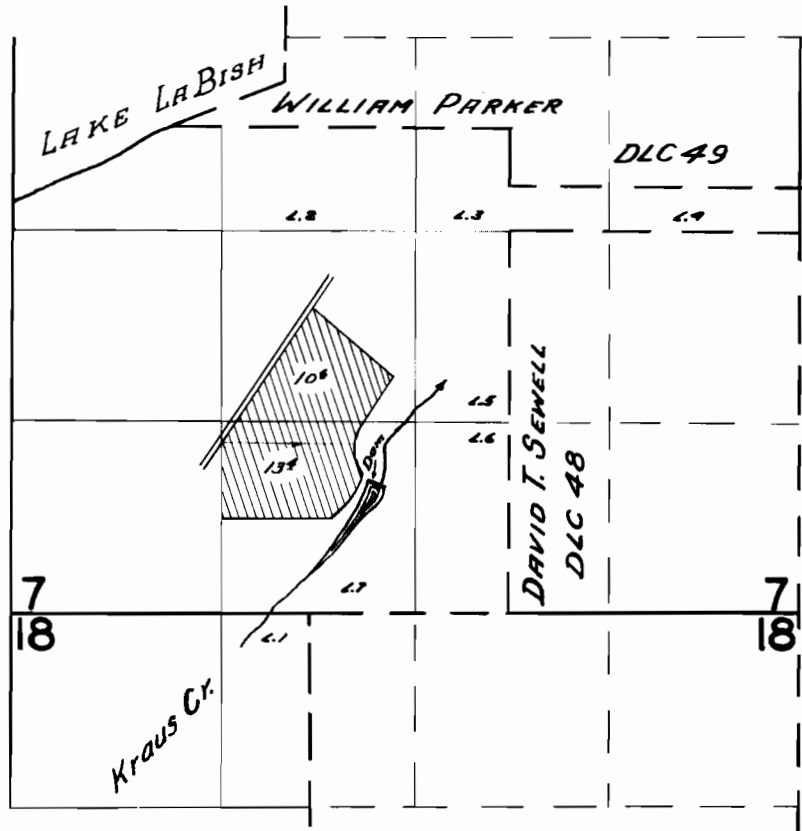

FINAL PROOF SURVEY

UNDER

Application No. ^{R-25171} ~~25172~~ Permit No. ^{R-1115} ~~20173~~

IN NAME OF

.....*T. W. Bump*.....

Surveyed *May 25* 1956, by *C. O. Bartels*.....