


T. 3 S. R. 3 W. W. M.

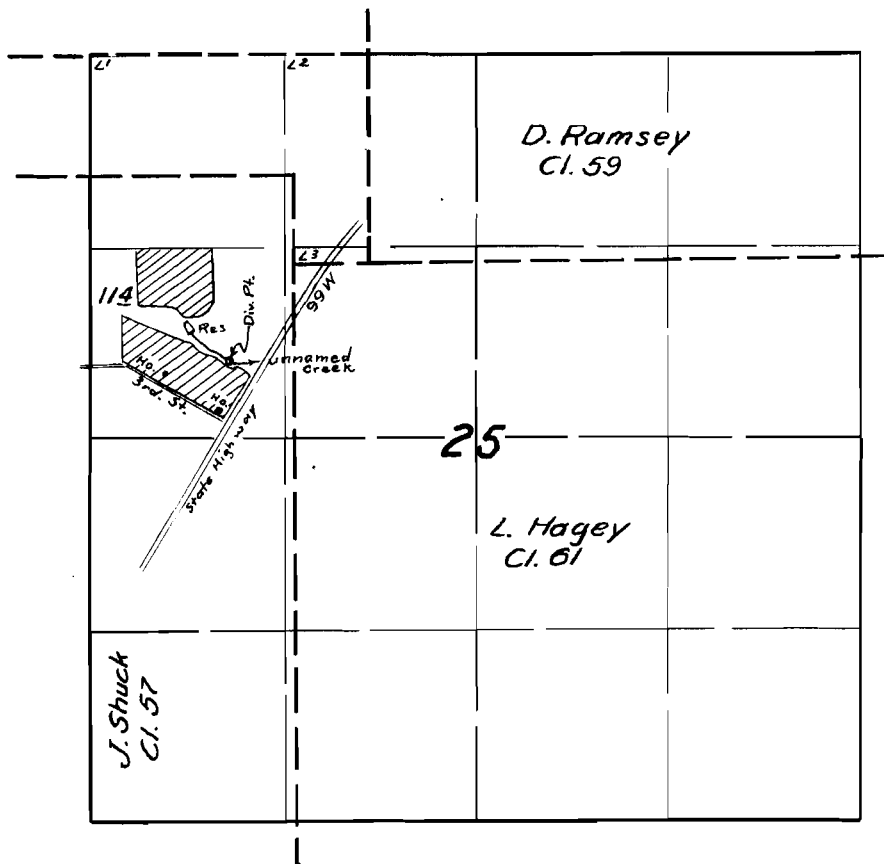

**FINAL PROOF SURVEY**

UNDER

R-25263

R-1194

Application No. 25264 Permit No. 20501

IN NAME OF

Earl Namitiz

Surveyed Mar. 22 1956, by Tom Bish