


T. 3 S. R. 3 W. W. M.

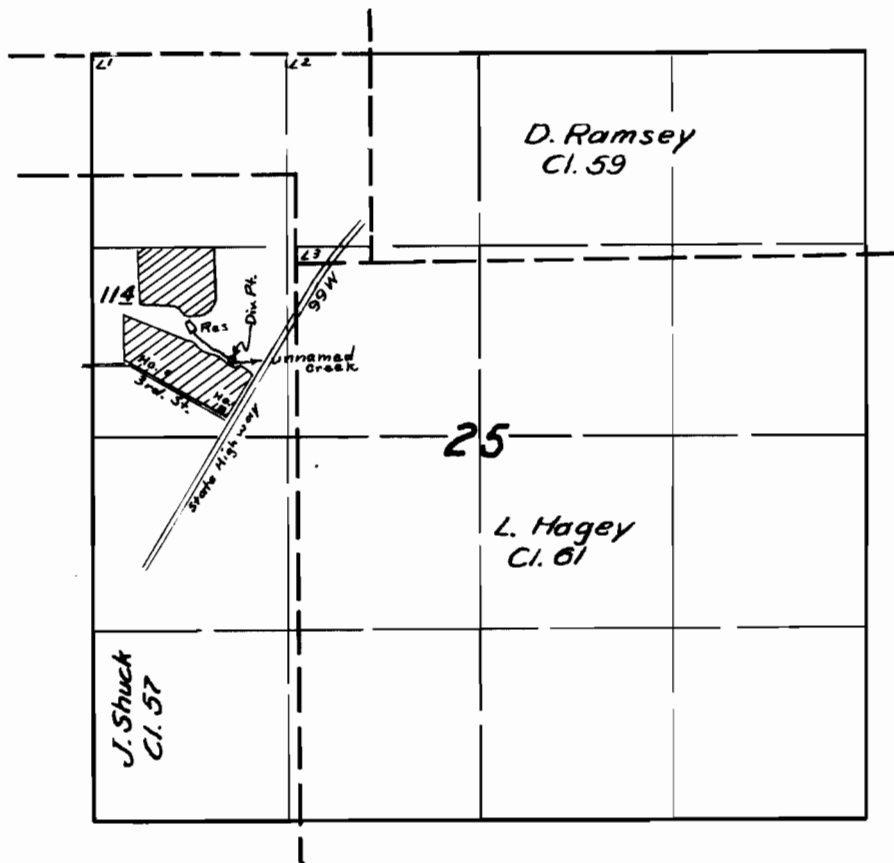

FINAL PROOF SURVEY

UNDER

R-25263

R-1194

Application No. ~~25264~~ Permit No. ~~20501~~

IN NAME OF

Earl Namitiz

Surveyed Mar 22 1956, by J. M. Bish