


T. 8 N. R. 10 W. W. M.

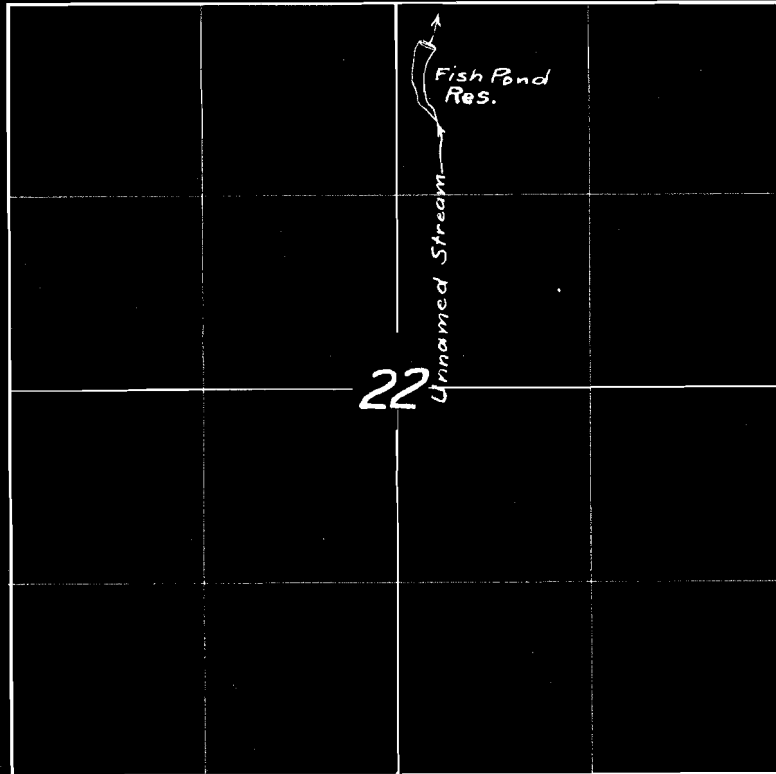

FINAL PROOF SURVEY

UNDER

R-25973

R-1217

Application No. 25840 Permit No. 20528

IN NAME OF

Toivo Puustinen

Surveyed 12 Sept. 1956, by *M. Bish*