


T. 5 S. R. 3 W. W. M.

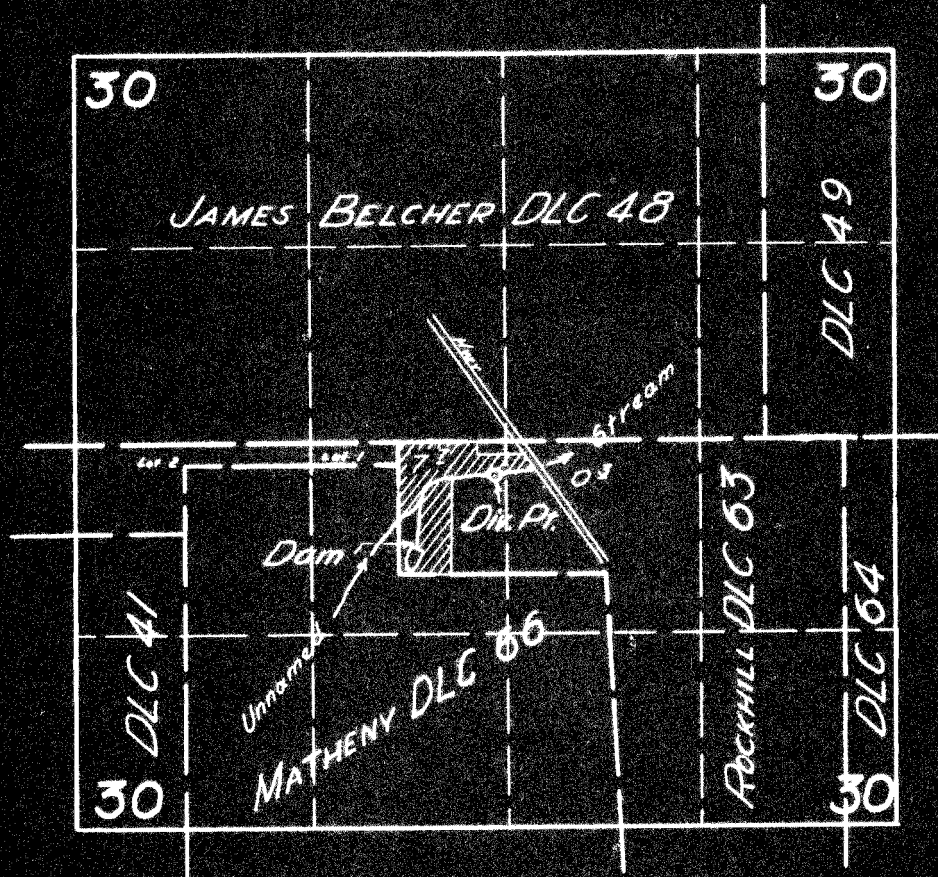

FINAL PROOF SURVEY

UNDER

Application No. 26152 Permit No. 20585
R-26413 R-1249

IN NAME OF

GEORGE W. POLVI

Surveyed 21 Mar 1956, by [Signature]