


T. 5 S. R. 3 W. W. M.

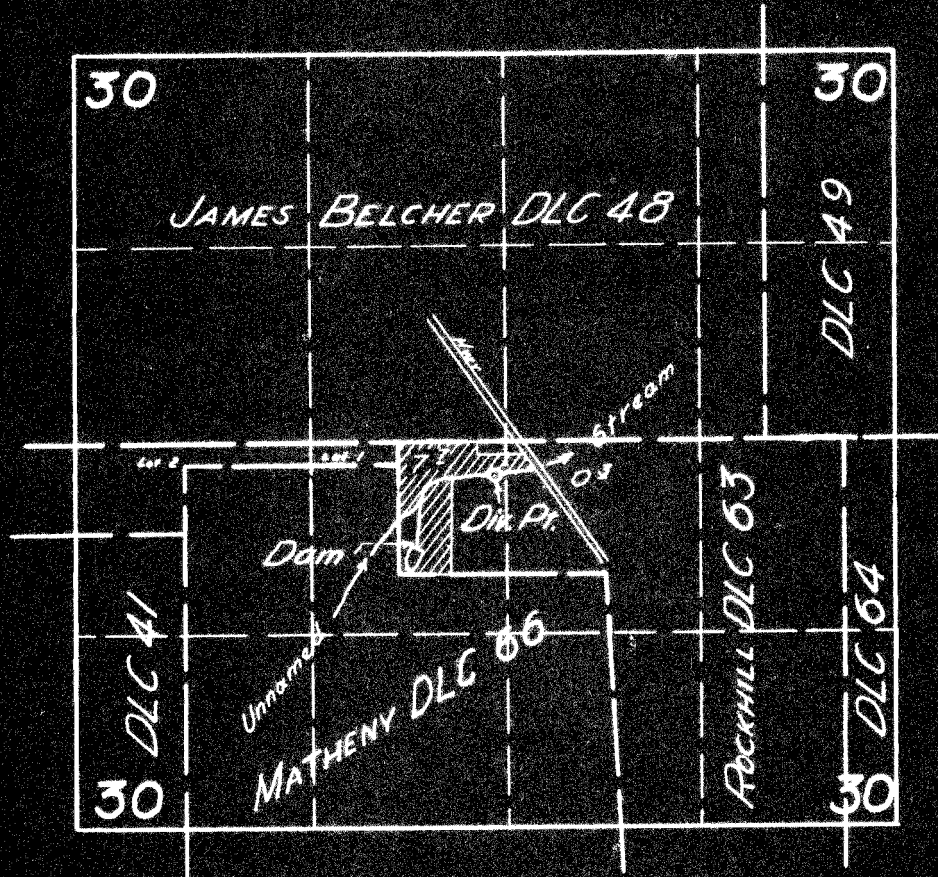

**FINAL PROOF SURVEY**

UNDER

Application No. 26152 20585  
R-26413 Permit No. R-1249

IN NAME OF

**GEORGE W. POLVI**

Surveyed 21 Mar 1956, by [Signature]