


T.26S. R. 6W.W.M.

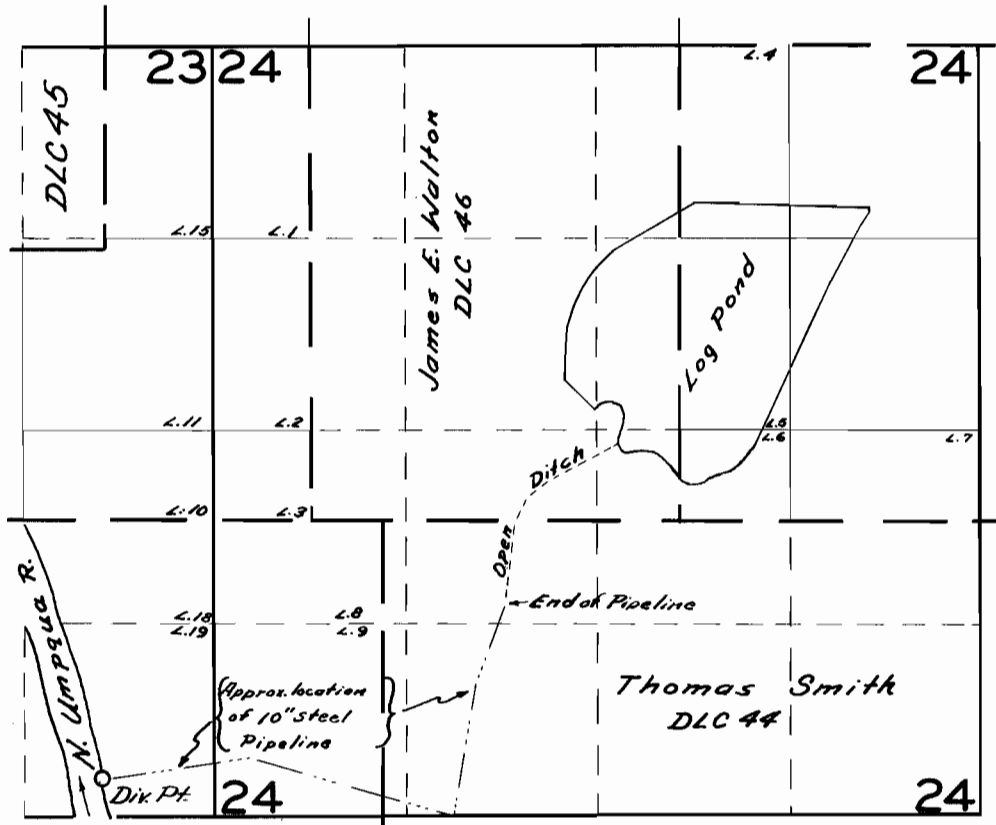

FINAL PROOF SURVEY

UNDER

Application No. R-25774 25775 Permit No. R-1278 20855

IN NAME OF

Evans Products Co.

Surveyed June 10, 1956, by C.O. Bartels