


T.3 S. R. 3 W. W. M.

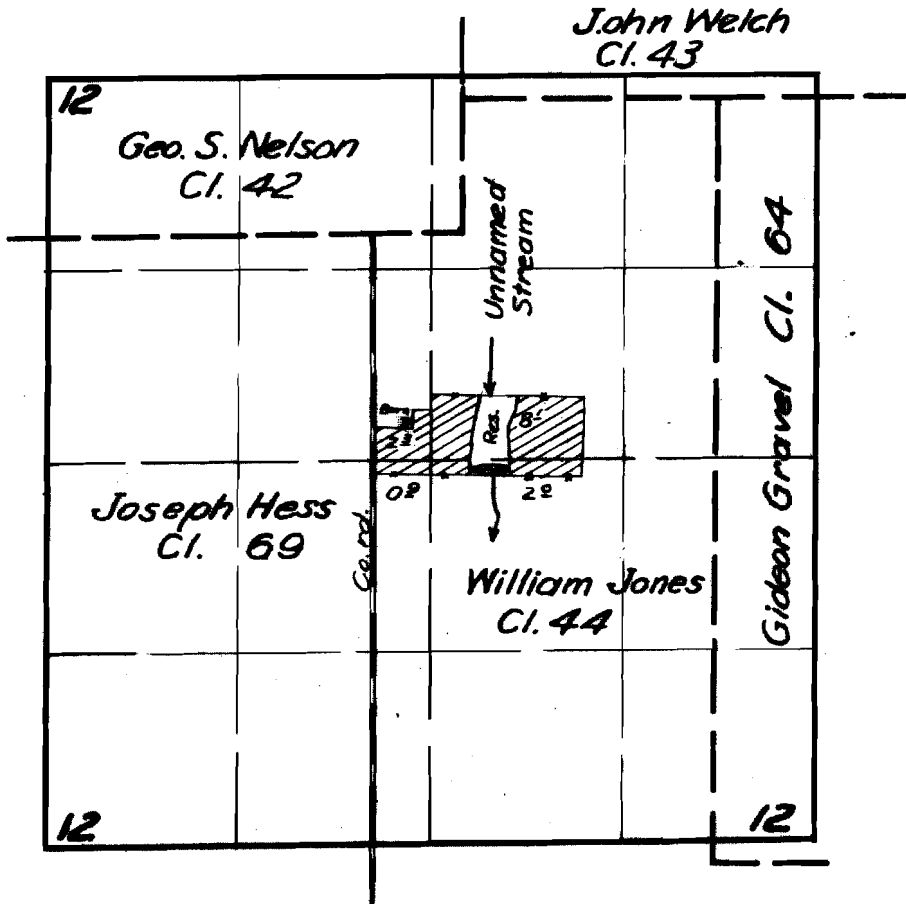

FINAL PROOF SURVEY

UNDER

R-26745

R-1292

Application No. ~~26746~~ Permit No. 20926

IN NAME OF

Ralph Lehmann

Surveyed Mar 21 1956, by M. Bush