


T.3S.R.3W.W.M.

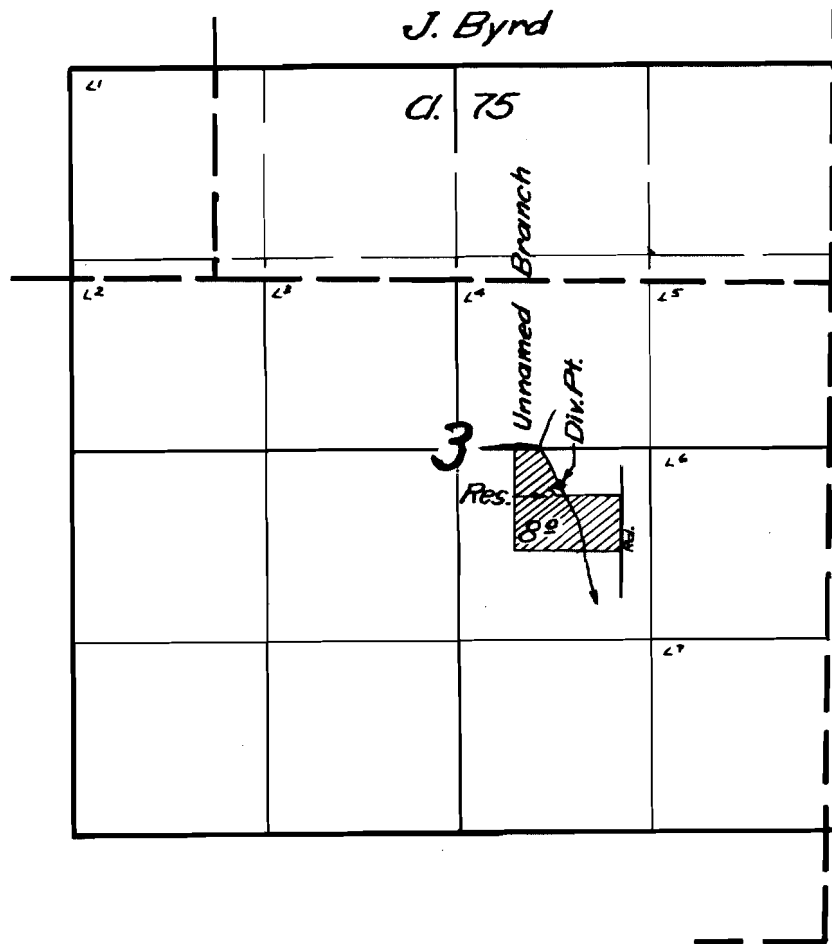

FINAL PROOF SURVEY

UNDER

R-27144

R-1345

Application No. 27145 Permit No. 21224

IN NAME OF

Charlie B. Lesperance

Surveyed Mar. 20 1956, by *Tm. Wish*