


T.6 N. R. 10 W. W.M.

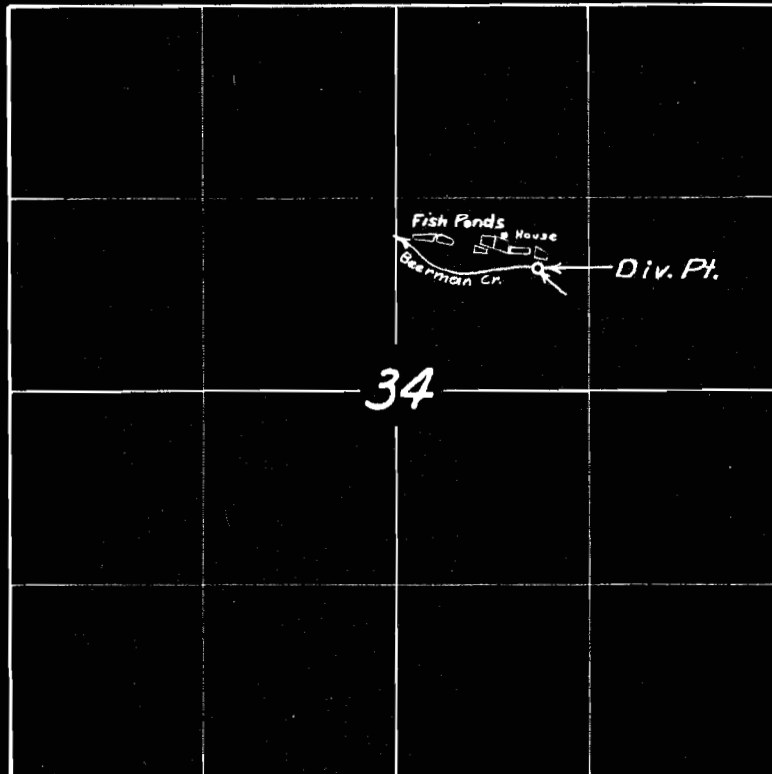

FINAL PROOF SURVEY

UNDER

R-27609

R-1429

Application No. 27608 Permit No. 21748

IN NAME OF

C. T. Chapman

Surveyed 21 Aug. 1956, by M. Bish