


T.5 S.R.3 W. W.M.

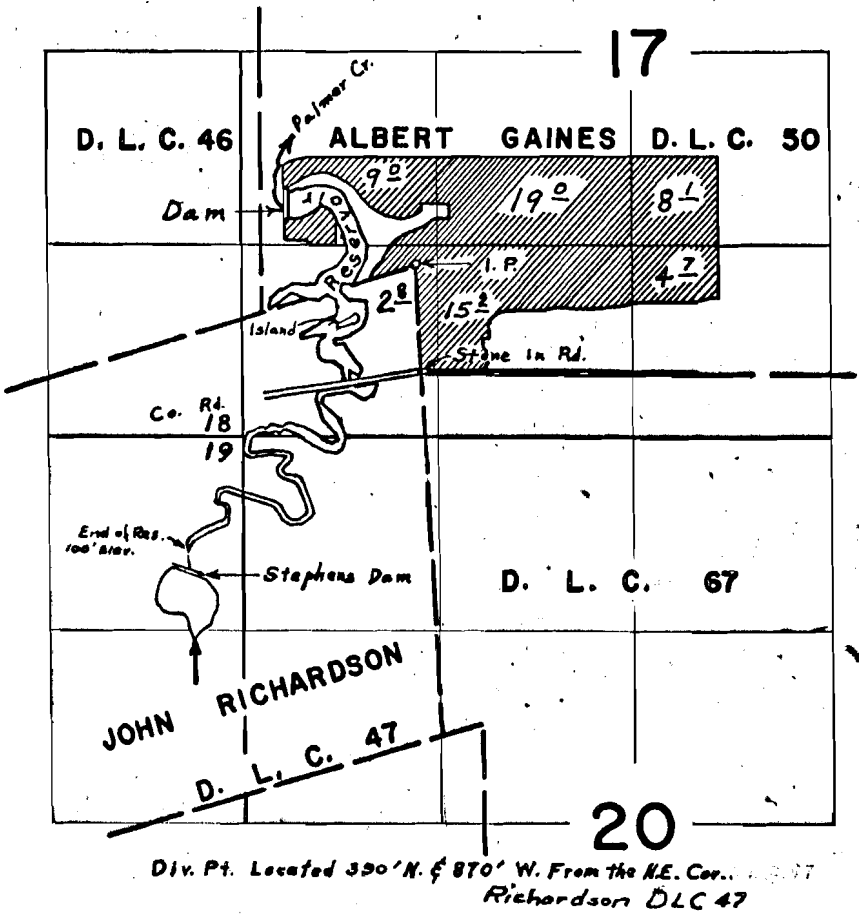

FINAL PROOF SURVEY UNDER

R-45955
 45956
 R-41619
 Application No. 41620 Permit No. 31035
 R-5466
 34327
 R-4683
 IN NAME OF

X. J. & IDA M. DAUENHAUER

Surveyed April 12, 1967, by L.E. Gauld
 Nov. 9, 1972 D. NORBY