


# T.5 S.R.3 W. W.M.

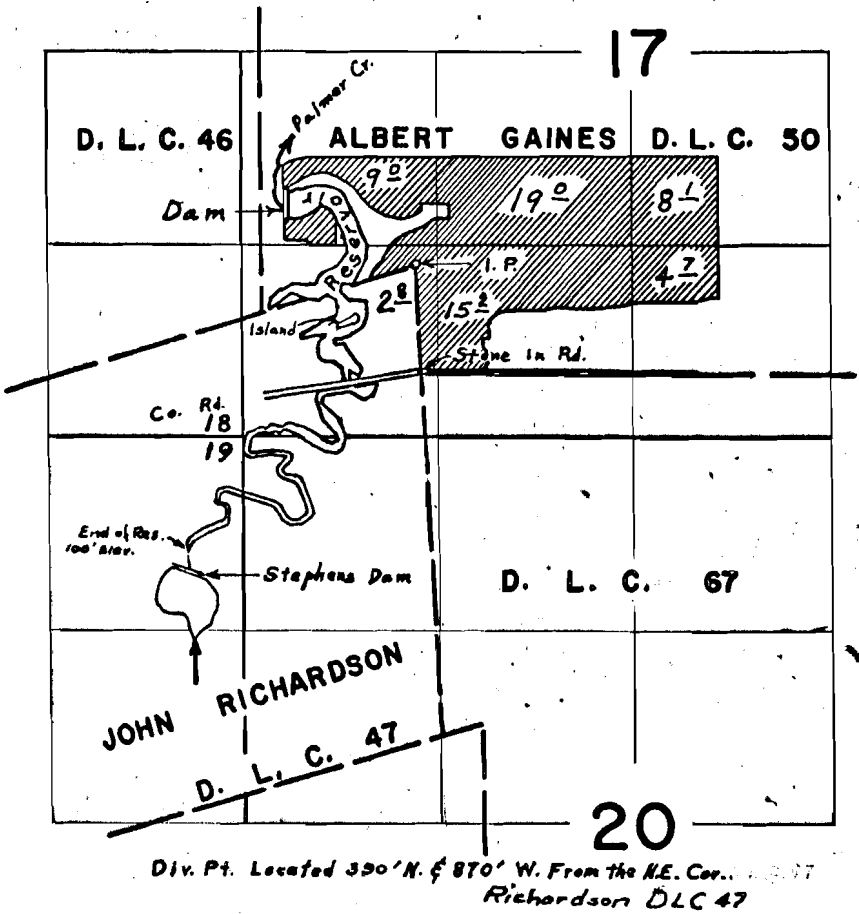

## FINAL PROOF SURVEY UNDER

R-45955      R-5466  
 45956      34327  
 R-41619      R-4683  
 Application No. 41620      Permit No. 31035  
 IN NAME OF

X. J. & IDA M. DAUENHAUER

Surveyed April 12, 1967, by L.E. Gauld  
 Nov. 9, 1972      D. NORBY