


TIN.R.IOW.W.M.

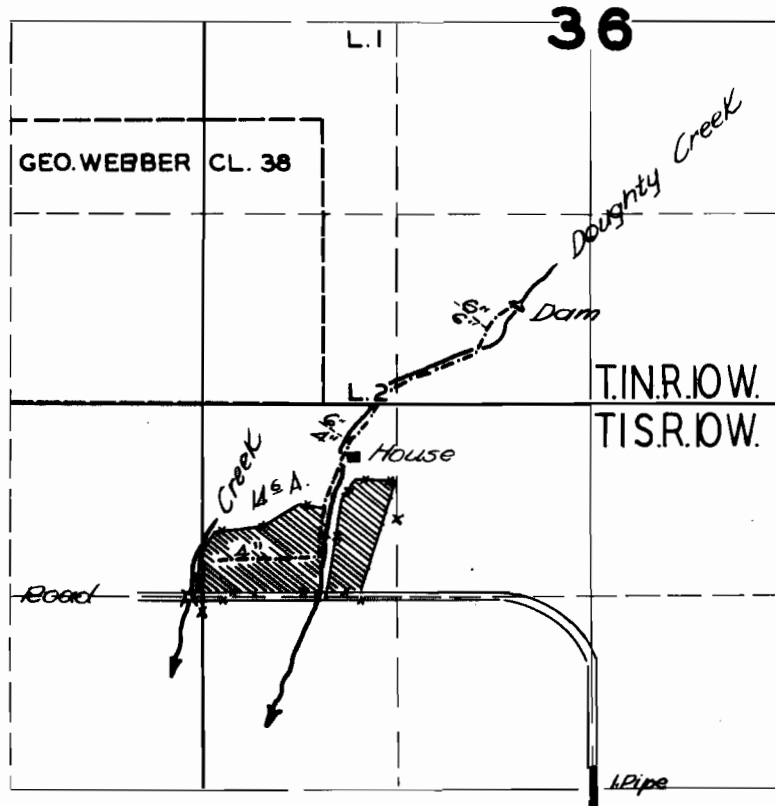

FINAL PROOF SURVEY

UNDER

Application No. 18072... Permit No. 13738

IN NAME OF

DR. C. E. MORRISON

Surveyed AUG. 23 1950., by H.L. COFFMAN