


T. 8 N. R. 7 W. W. M.

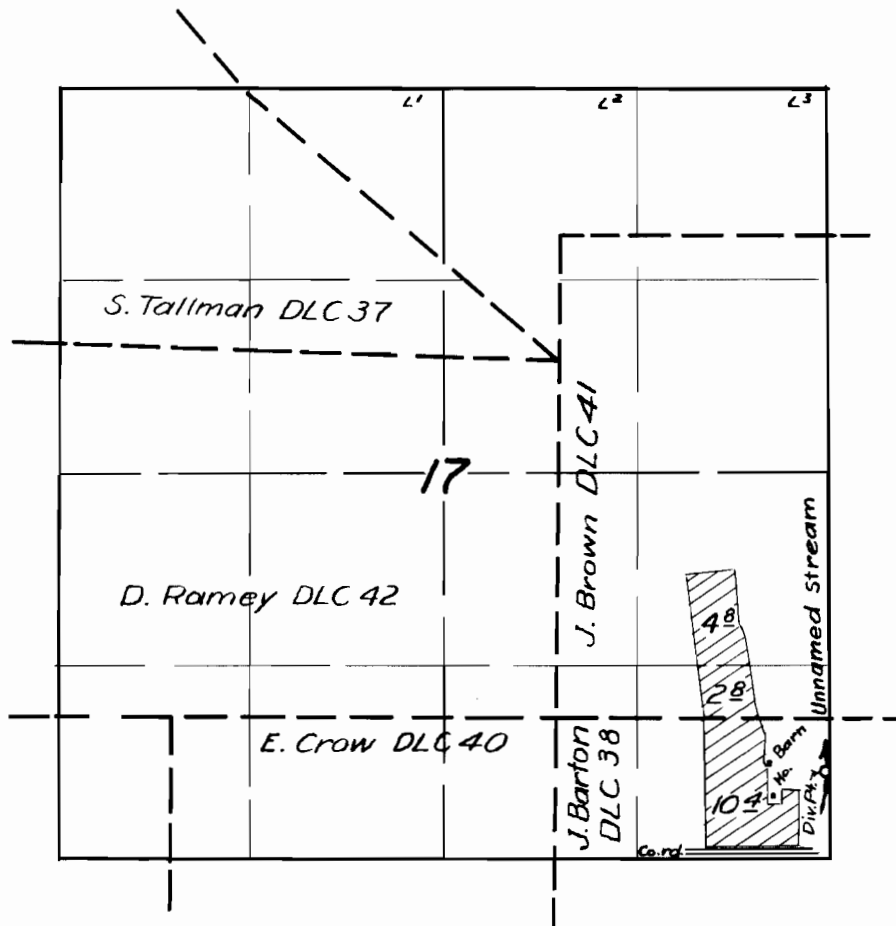

**FINAL PROOF SURVEY**  
UNDER

Application No. 20728 Permit No. 16228.  
IN NAME OF

Anderson C. Dale

Surveyed 17 Sept. 1956 by Tom B. ...