


T. 6 S. R. 1 W. W. M.

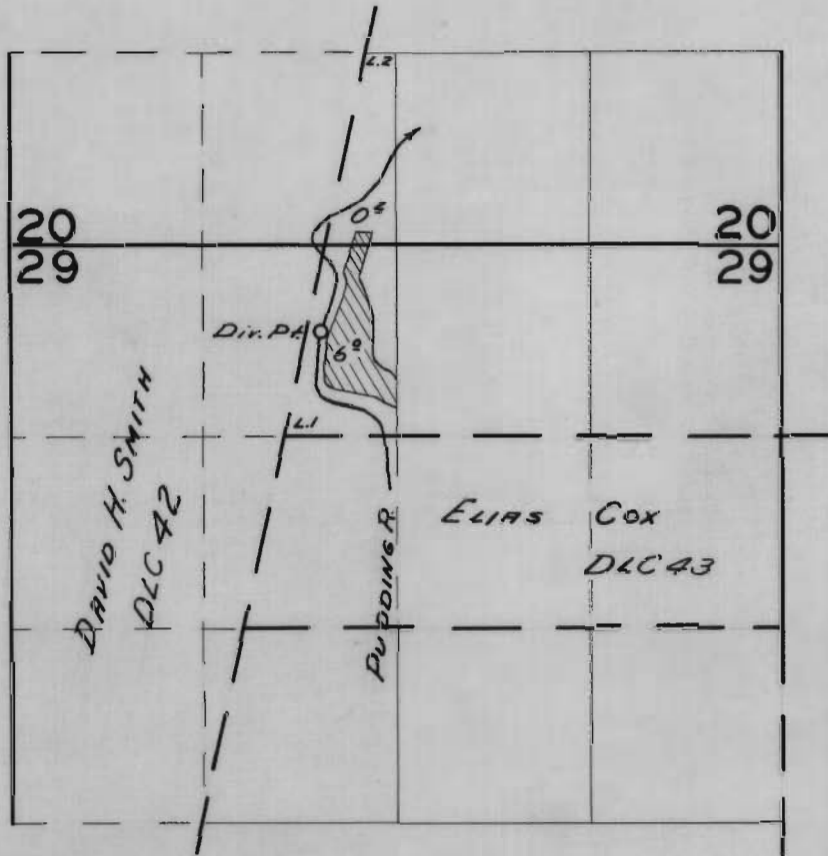

FINAL PROOF SURVEY

UNDER

Application No. 20853 Permit No. 16333

IN NAME OF

L. & VERNIEGE MEISENHEIMER

Surveyed MAY 24 1956, by C. O. BARTELS