


T. 9S. R. 40E.W.M.

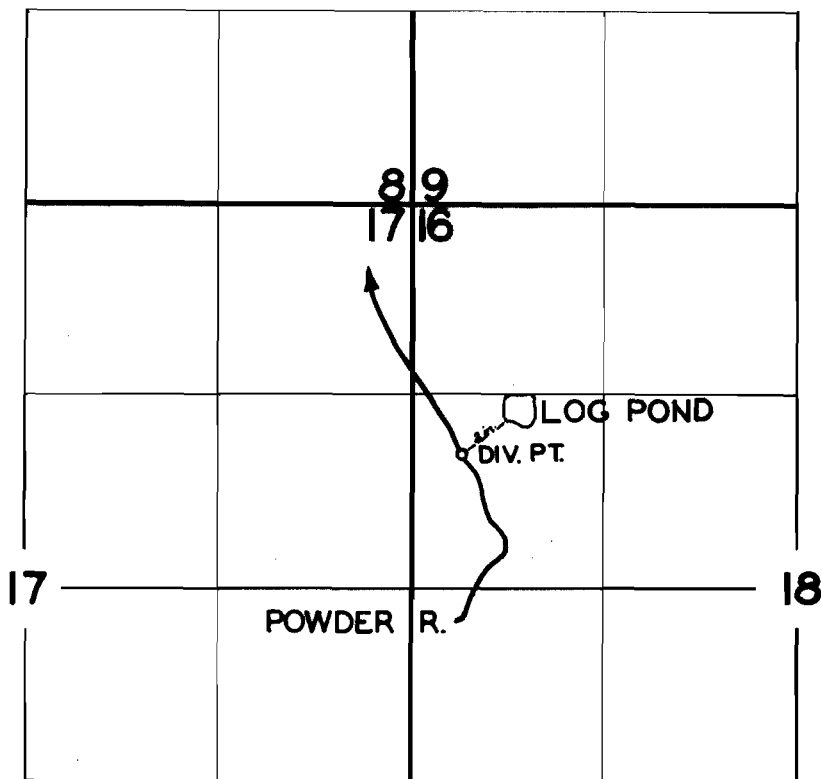

FINAL PROOF SURVEY
UNDER

Application No. 21580 Permit No. 16958
IN NAME OF

EASTERN OREGON LUMBER MILL

Surveyed 22 MAY 1956 by MIKE BISH

RB