


T. 6 S. R. 1 W. W. M.

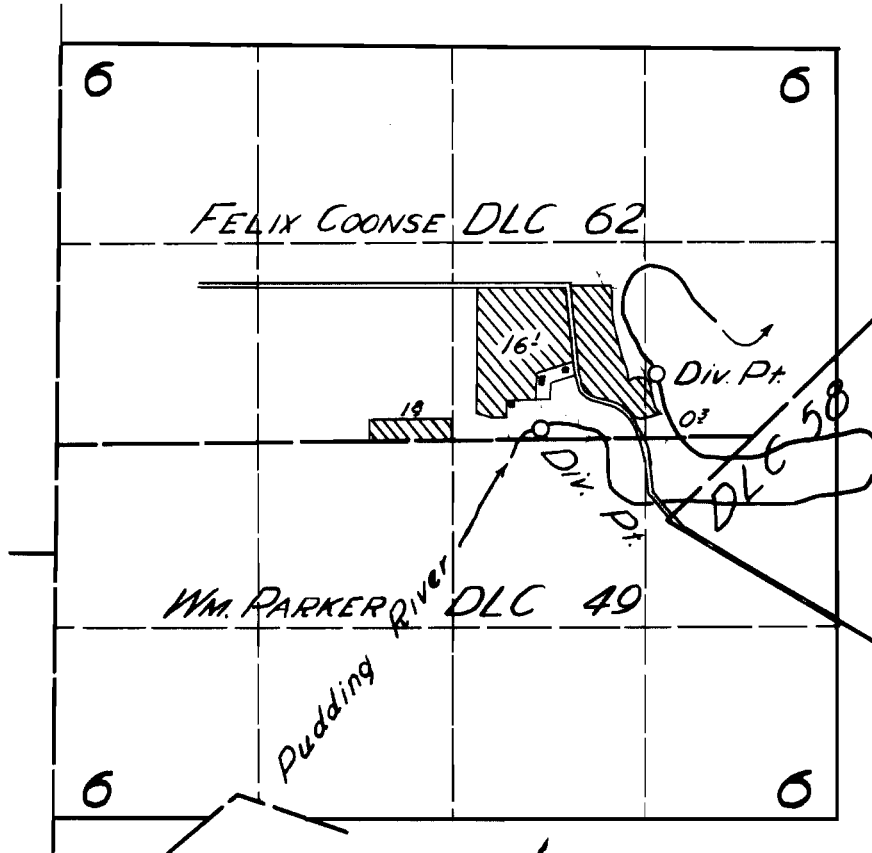

**FINAL PROOF SURVEY**

UNDER

Application No. 21624 Permit No. 16991

IN NAME OF

ALBERT W. BOCHSLER

Surveyed 8 June 1956, by [Signature]