


T. 8S. R. 40E. W.M.

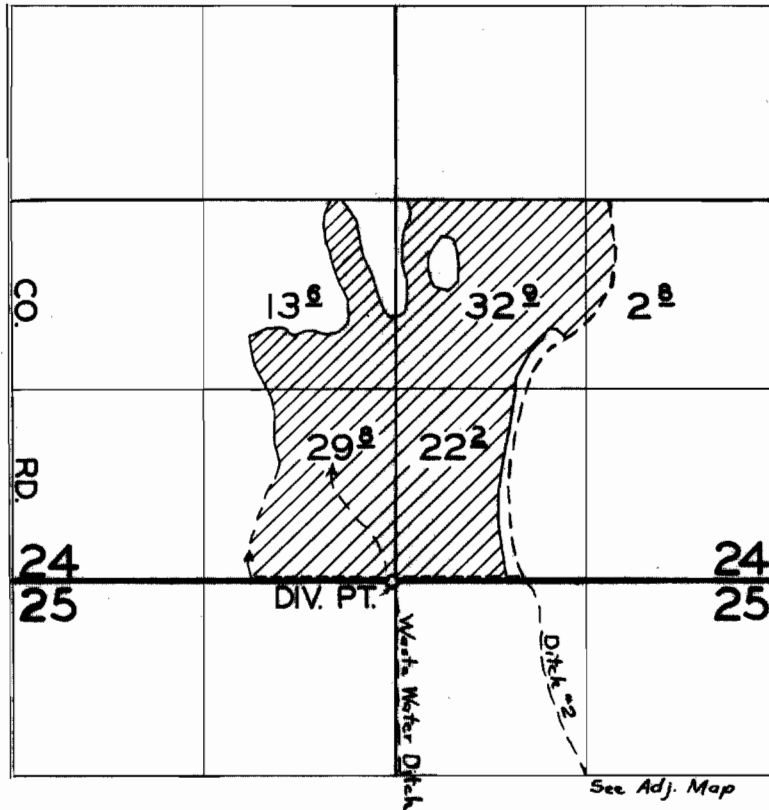

FINAL PROOF SURVEY

UNDER

Application No. 22461 Permit No. 17712

IN NAME OF

J. E. PROWELL

Surveyed 31 MAY 1956, by M. BISH

PLANT