


T.18 S. R. 47 E. W.M.

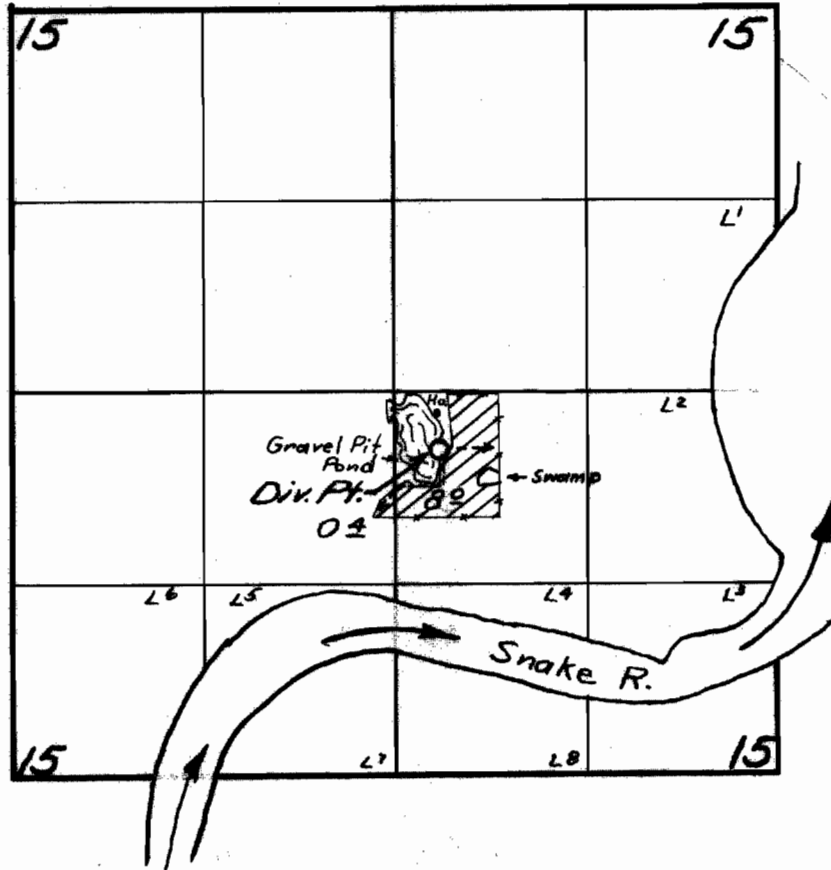

FINAL PROOF SURVEY

UNDER

Application No. 22648 Permit No. 17830

IN NAME OF

DARRELL KNAPP

Surveyed Oct. 4 1955, by Tom Bish