


T. 4 S. R. 2 E. W.M.

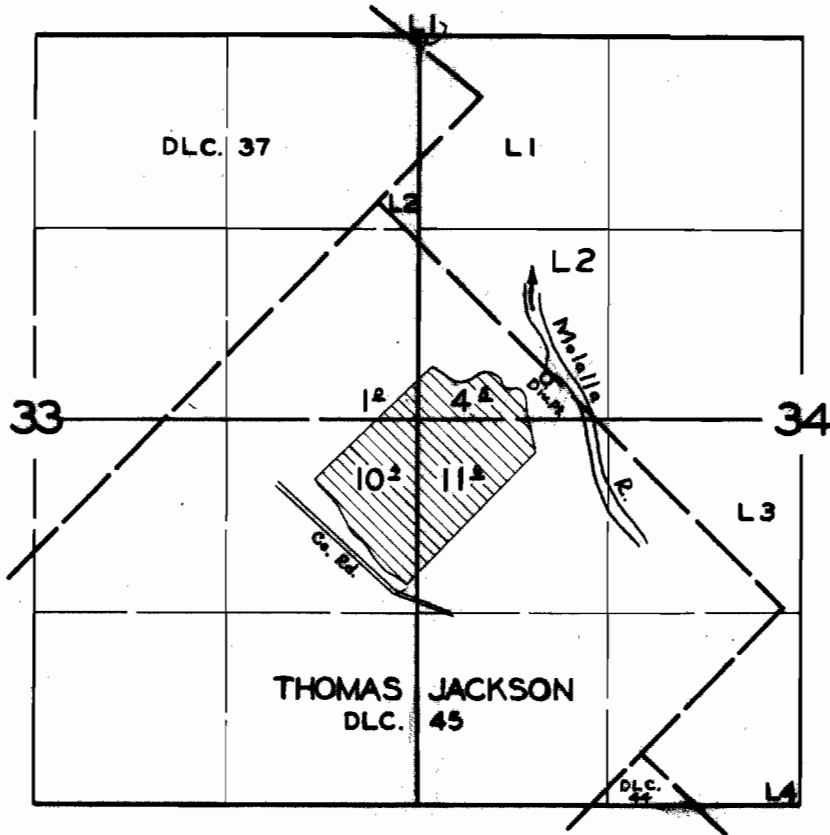

FINAL PROOF SURVEY

UNDER

Application No. ~~22688~~ Permit No. ~~17043~~

IN NAME OF

MRS. ETTA GOSSER

Surveyed ~~13~~MAR. 1956, by ~~R.D.~~BEST