


T. 9 S. R. 4 W. W. M.

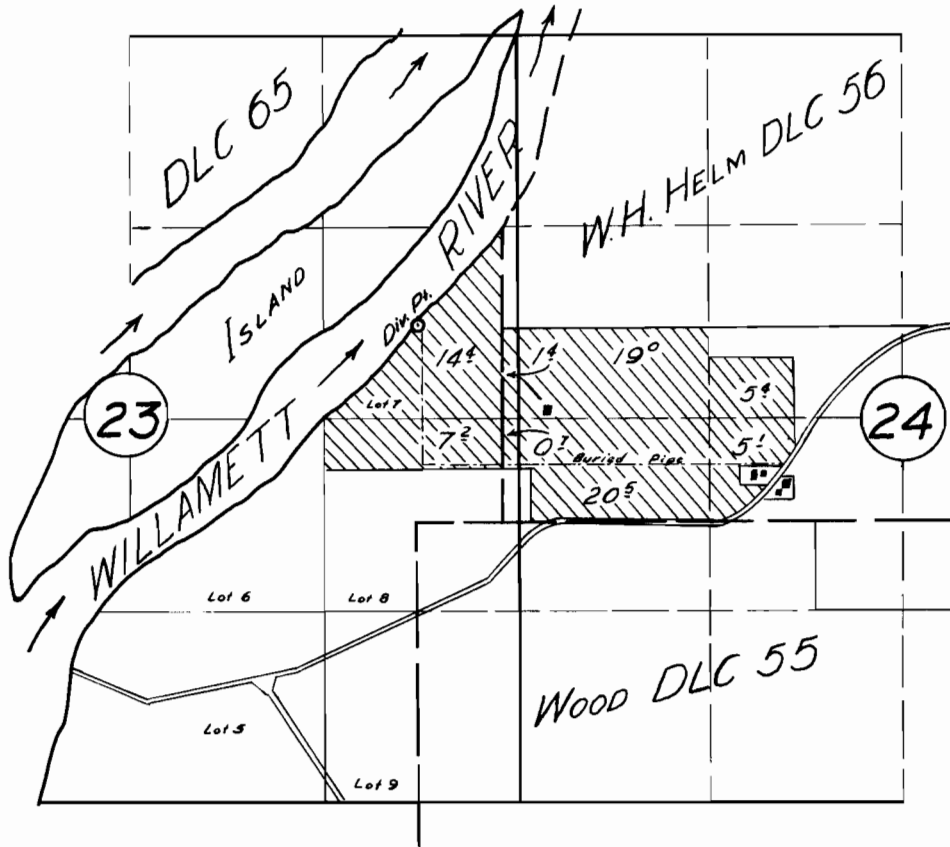

FINAL PROOF SURVEY

UNDER

Application No. 22781 Permit No. 18036

IN NAME OF

JAKE W. GILMOUR

Surveyed 6 Apr. 1956, by *P. Whitby*