


T.28S. R.8W.W.M.

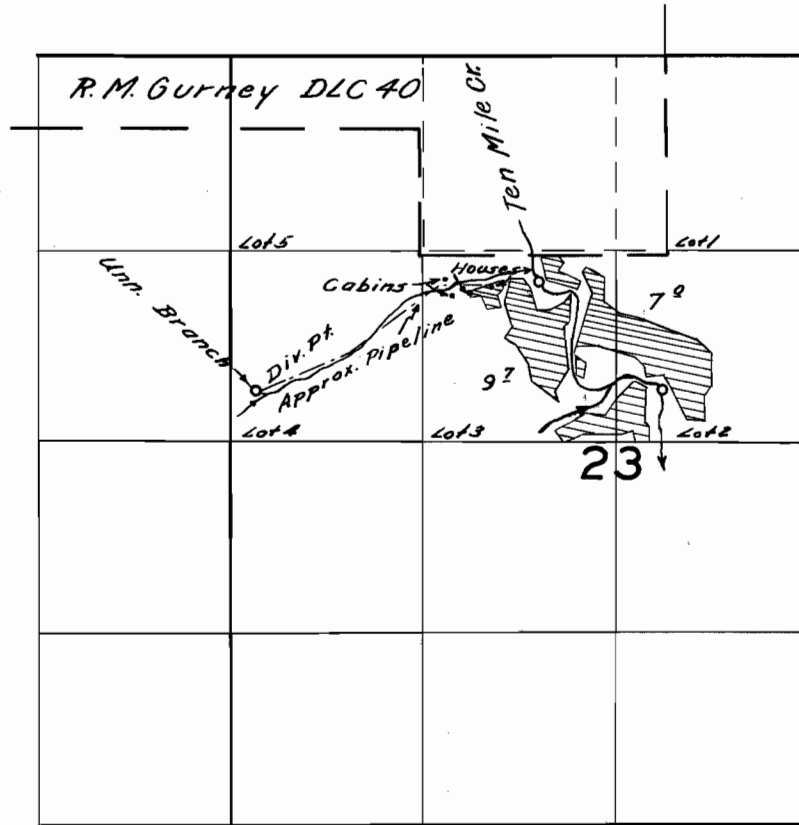

**FINAL PROOF SURVEY**

UNDER

Application No. 23400 Permit No. 18473

IN NAME OF

Fred & Edith Frisbie

Surveyed Aug. 9 1956, by C. O. Bartels