


# T.5S.R.1W.W.M.

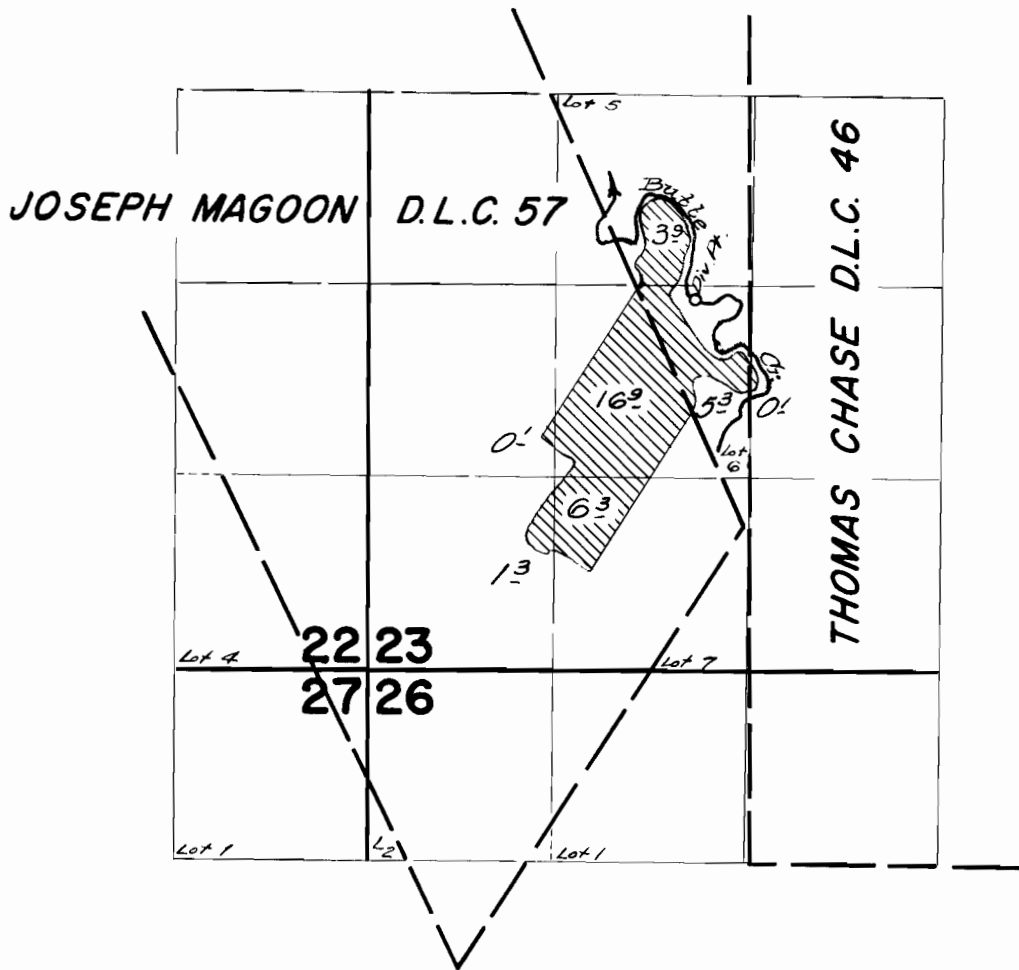

## FINAL PROOF SURVEY UNDER

Application No. **23482** Permit No. **18574**  
IN NAME OF

**FRANCIS M. & FRANCES M. KEETON**

Surveyed Feb. 29 1956. by *R.D. Best*

*RT*