


T. 8 N. R. 7 W. W. M.

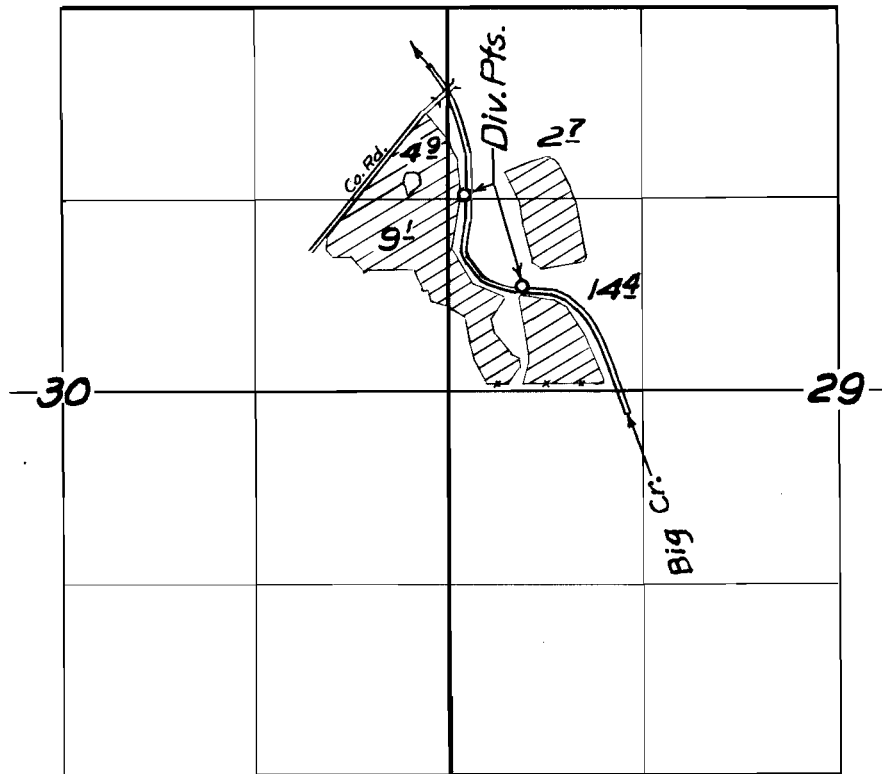

**FINAL PROOF SURVEY**  
UNDER

Application No. *23817* Permit No. *18671*  
IN NAME OF

*D.A. Messenger*

Surveyed *13 Sept.* 1956, by *Tm. Bush*