


T. 5 N. R. 7 W. W. M.

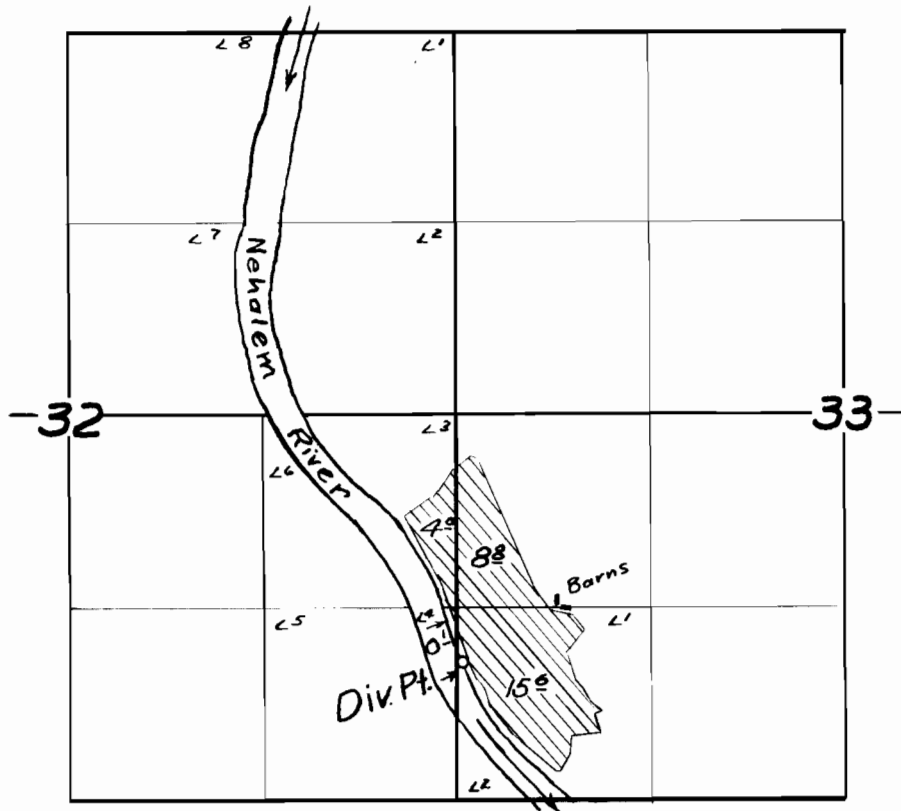

FINAL PROOF SURVEY
UNDER

Application No. 24107 Permit No. 18982
IN NAME OF

William H. & Charles M. Meeker

Surveyed 10 July 1956 by T. B. Bish