


T.4 S. R. 4 W.W.M.

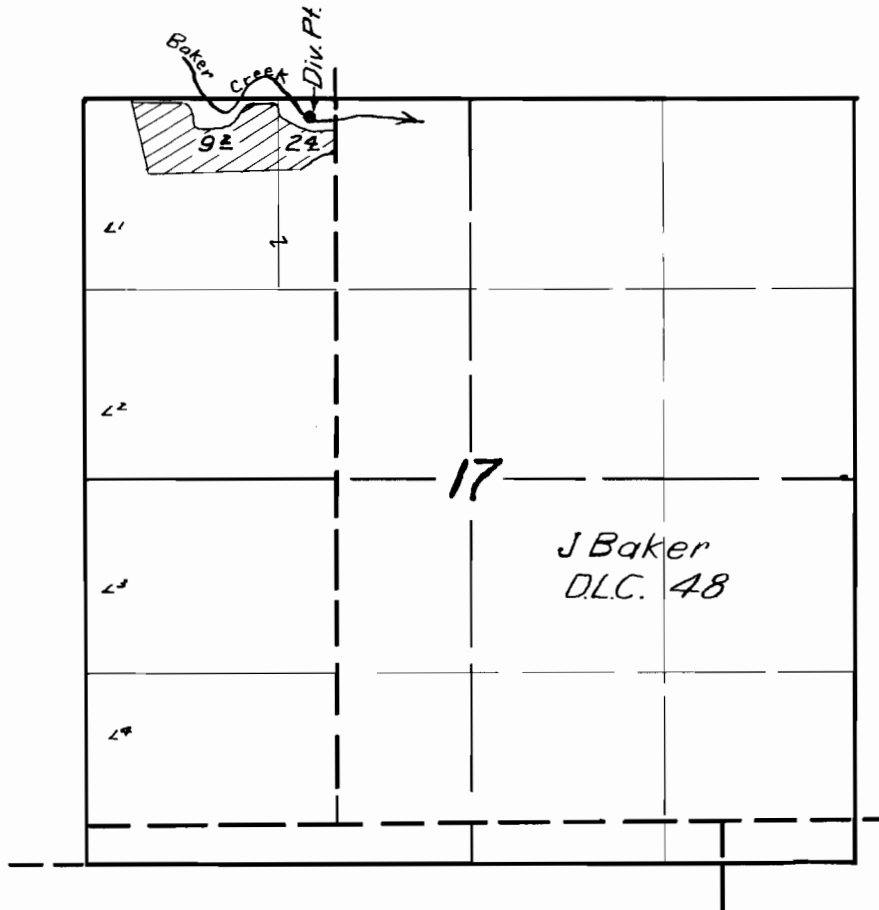

**FINAL PROOF SURVEY**

UNDER

Application No. 24259 Permit No. 19041

IN NAME OF

Moss T. Compton & Glen L. Rowell

Surveyed April 2 1956, by M. Beh