


T. 8 N. R. 7 W. W. M

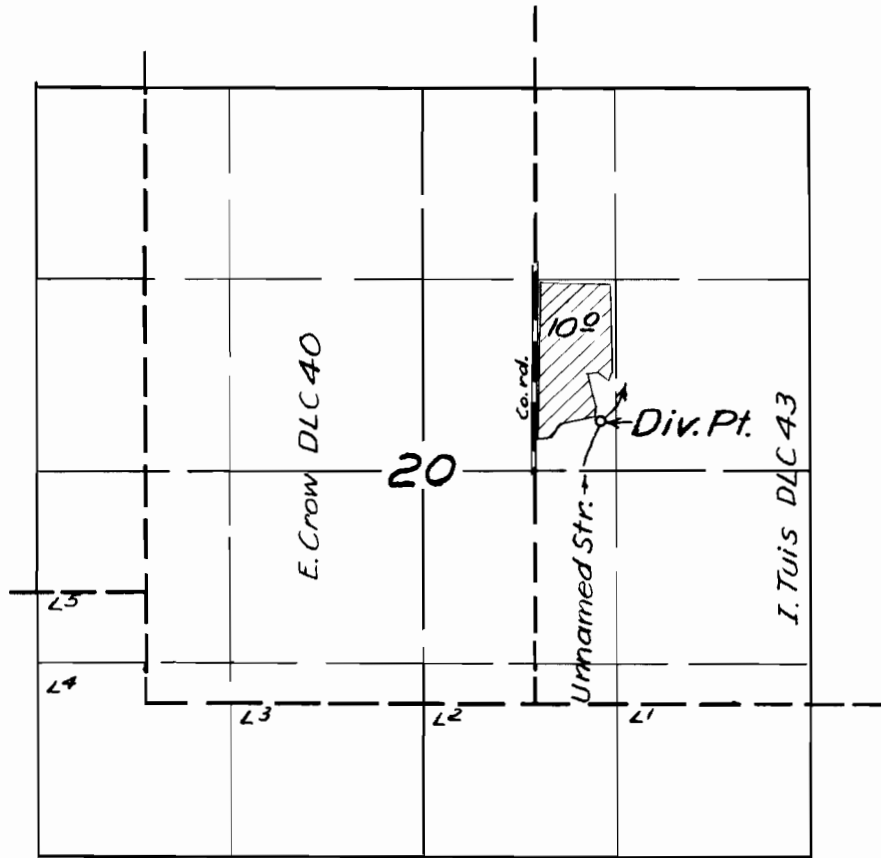

FINAL PROOF SURVEY

UNDER

Application No. 24346 Permit No. 19227

IN NAME OF

A. C. Dale

Surveyed 17 Sept. 1956, by Tom Bish