


T.3S.R.3W.W.M.

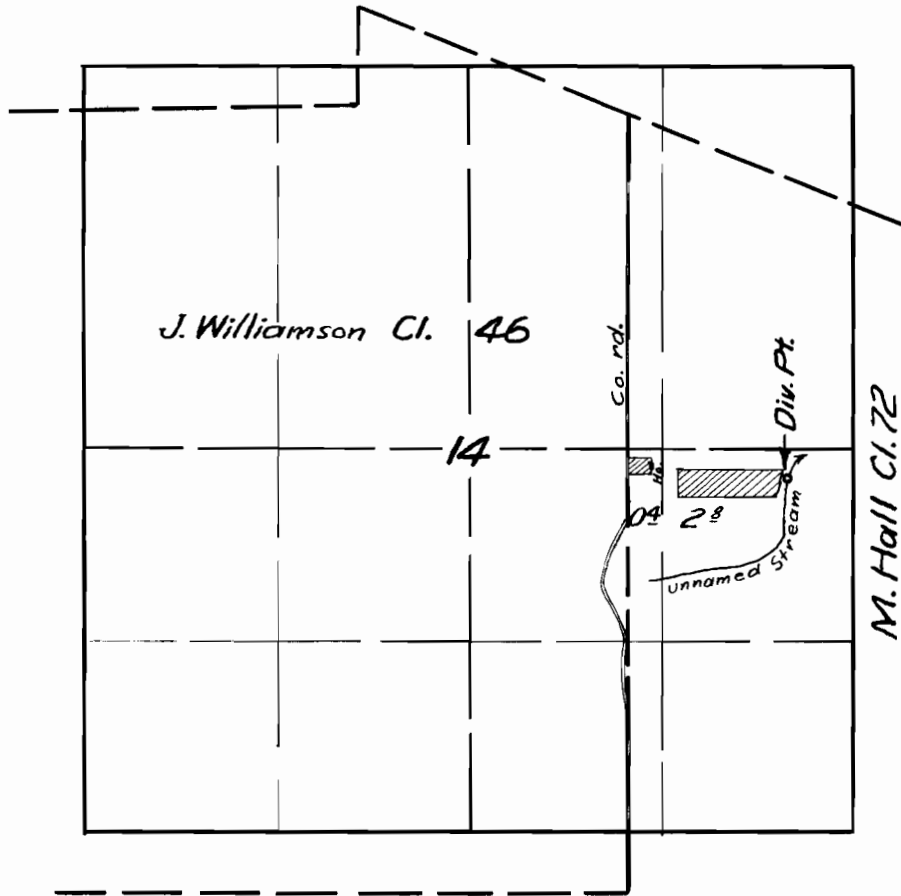

**FINAL PROOF SURVEY**

UNDER

Application No. 24465 Permit No. 19284...

IN NAME OF

Raymond W. Weatherly

Surveyed Mar. 22 1956, by J. M. Bish...