


T. 5 S. R. 1 W. W.M.

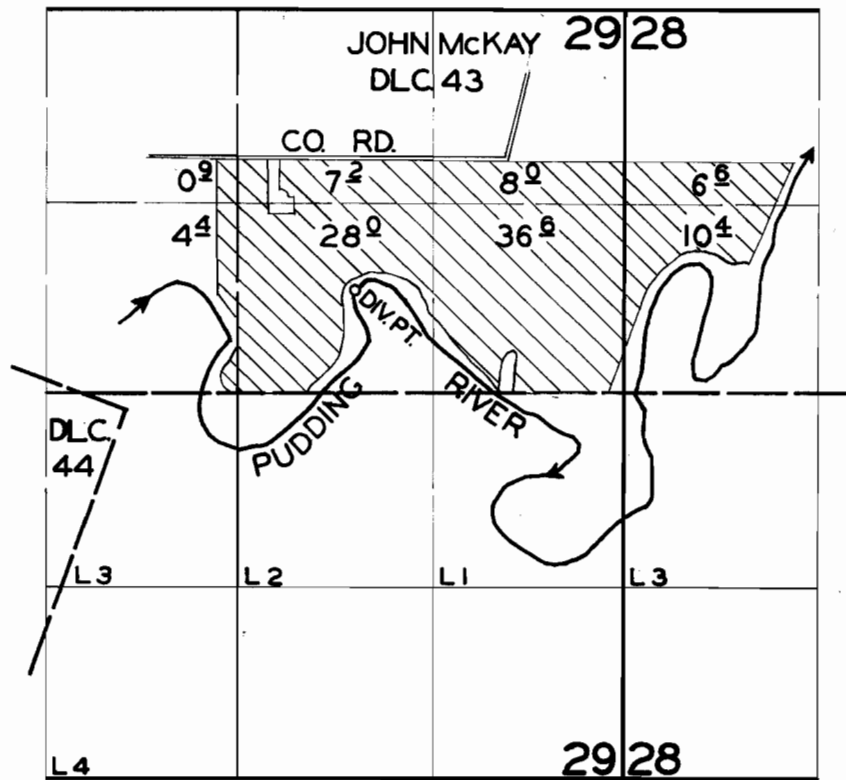

**FINAL PROOF SURVEY**  
UNDER

Application No. **24428** Permit No. **19262**  
IN NAME OF

**CLYDE BAUMAN**

Surveyed 1 MAR. 1956, by R. D. BEST