


T.4-5S. R.IW.W.M.

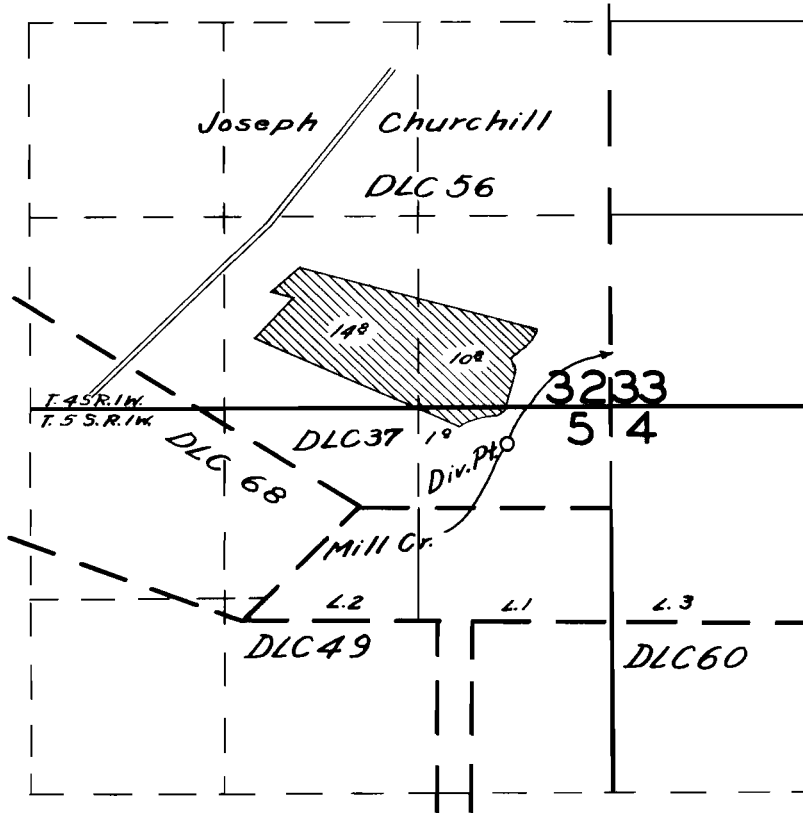

**FINAL PROOF SURVEY**

UNDER

Application No. *23998* Permit No. *19333*

IN NAME OF

*Marvin J. Barrett*

Surveyed *June 20, 1956*, by *C.O. Bartels*