


T. 5 S. R. 1 W. W. M.

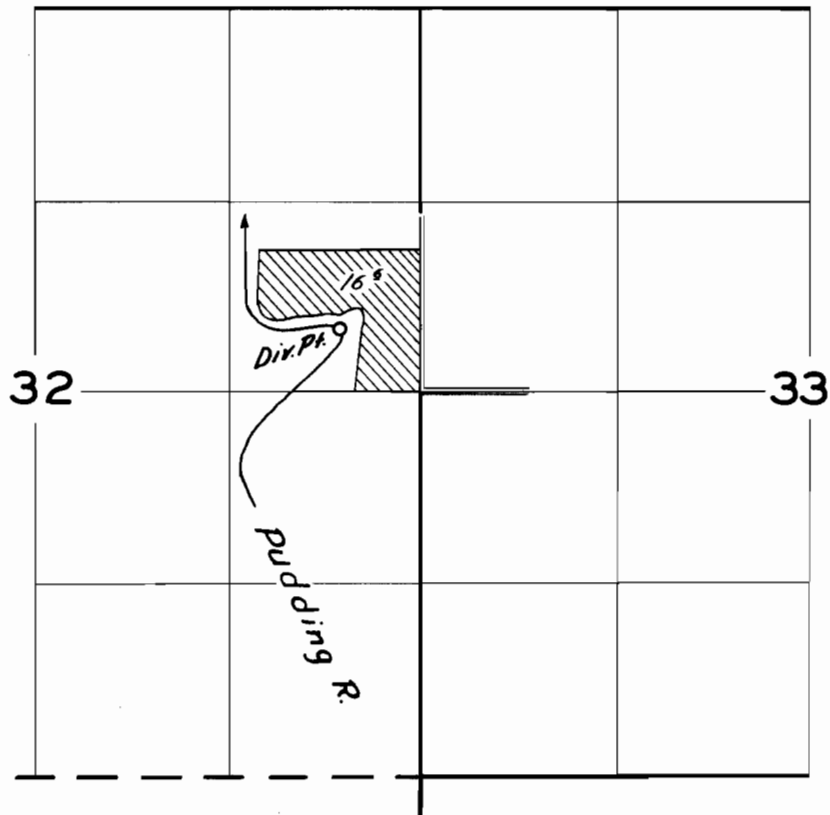

FINAL PROOF SURVEY

UNDER

Application No. 25305 Permit No. 19973

IN NAME OF

Ludwig Kappel

Surveyed May 31, 1956, by C.O. Bartels