


T. 3 & 4 S. R. 4 W. W.M.

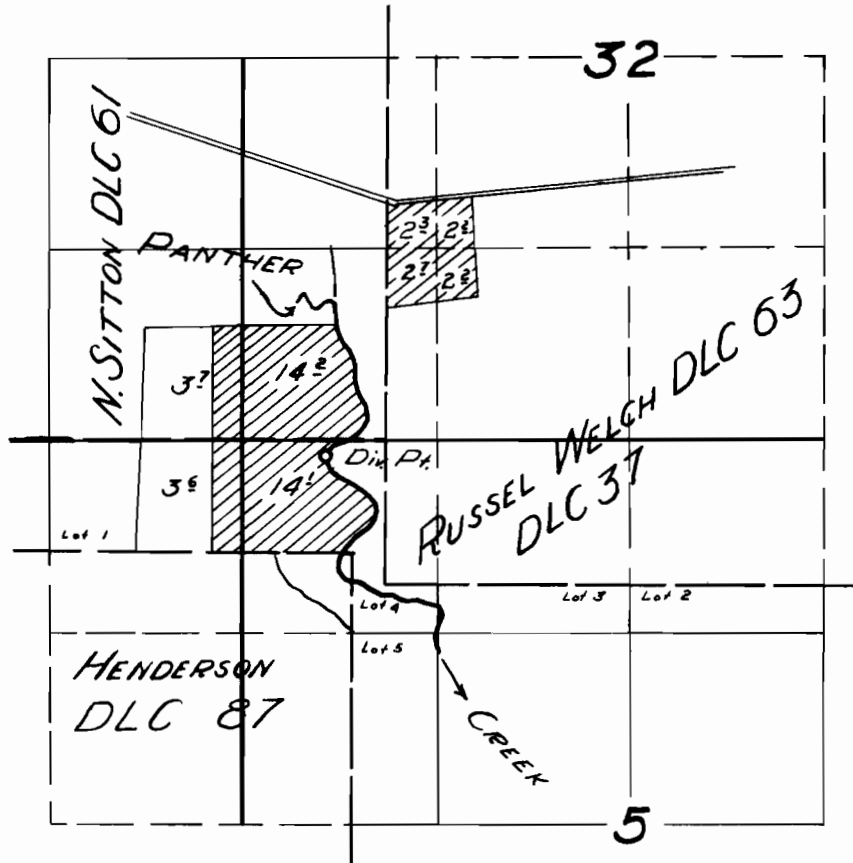

FINAL PROOF SURVEY
UNDER

Application No. 25403 Permit No. 19998
IN NAME OF

CHRIS W. SIMONSON

Surveyed 3 Apr. 1956, by [Signature]