


T. 5 N. R. 7 W. W. M.

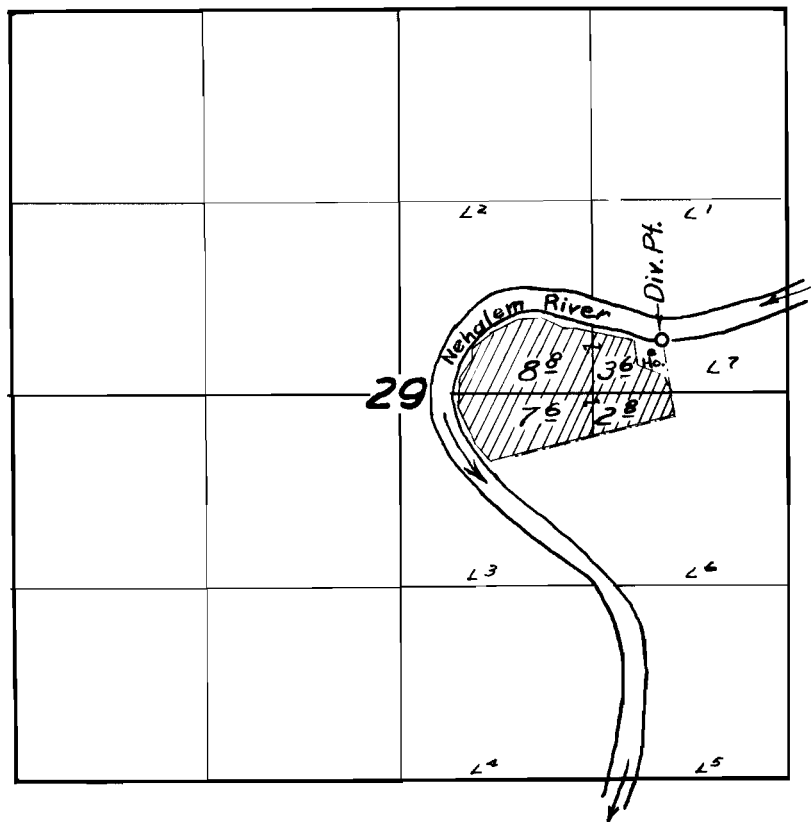

FINAL PROOF SURVEY
UNDER

Application No. 25526 Permit No. 20051

IN NAME OF

Einar Glaser

Surveyed 14 Aug. 1956, by Tm. Bish