


T. 4S. R. 2E. W.M.

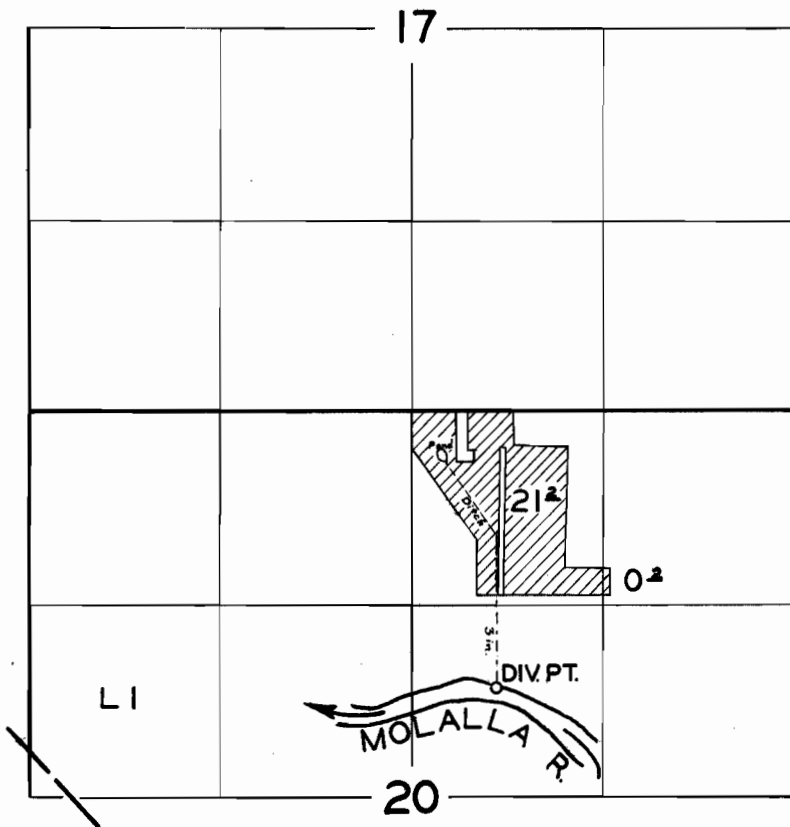

**FINAL PROOF SURVEY**  
UNDER

Application No. 25543 Permit No. 20057  
IN NAME OF

FRED H. WALLACE

Surveyed 13 MAR. 1956, by R. D. BEST

2/25