


T. 5 S. R. 5 W. W.M.

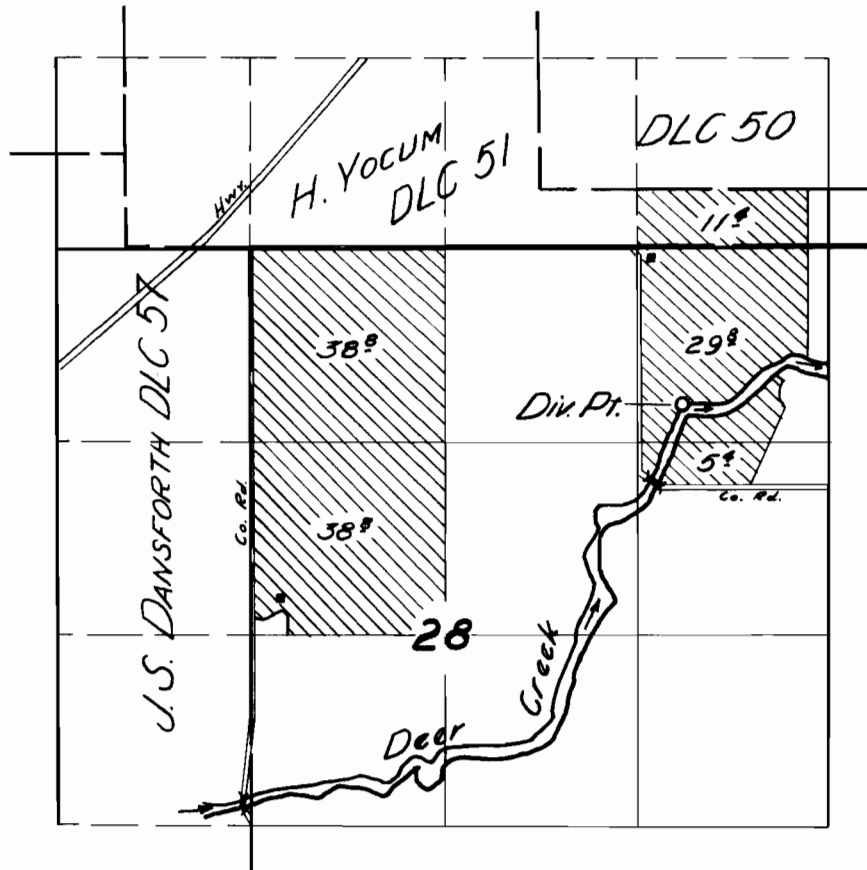

FINAL PROOF SURVEY

UNDER

Application No. 25548 Permit No. 20061

IN NAME OF

R. L. WALKER

Surveyed 23 Mar 1956, by [Signature]