


T.3 S. R.4 W.W.M.

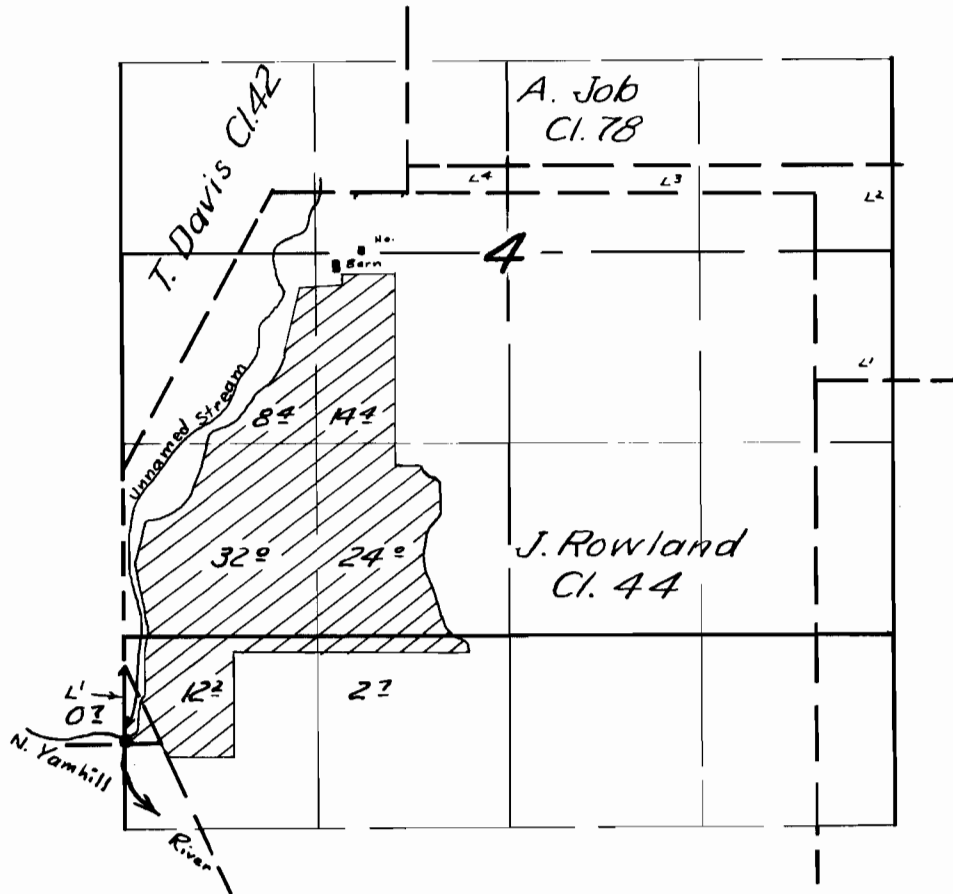

FINAL PROOF SURVEY

UNDER

Application No. 25615 Permit No. 20096

IN NAME OF

Roger A. Dumdi

Surveyed April 2 1956 by Tom Bick