


T.22S. R.5W.W.M.

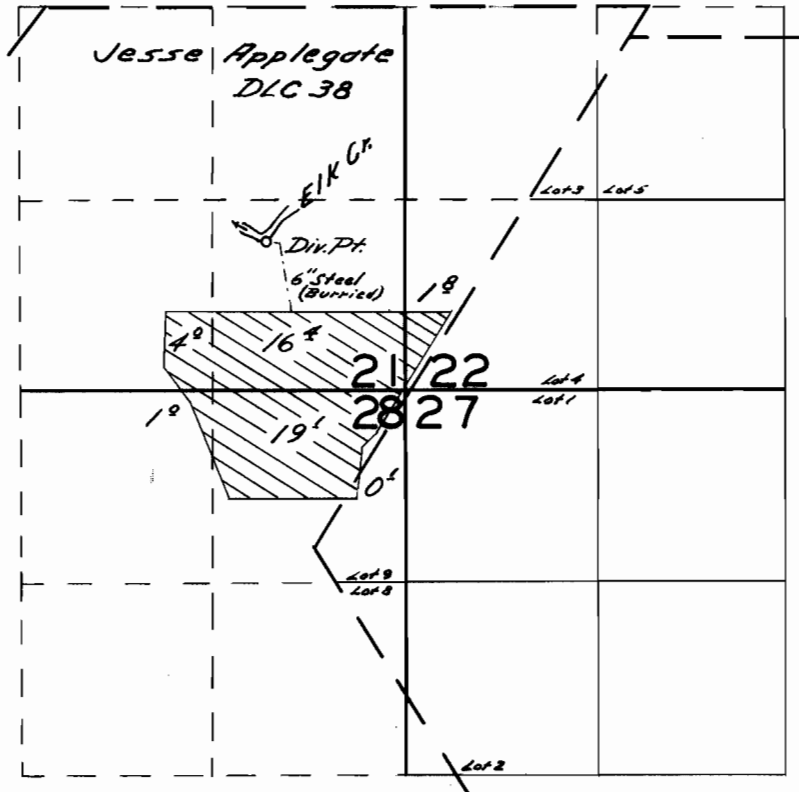

FINAL PROOF SURVEY

UNDER

Application No. 25675 Permit No. 20130

IN NAME OF

Paul Flury

Surveyed July 12 1956, by C.O. Bartsels