


T. 5 S. R. 3 W. W. M.

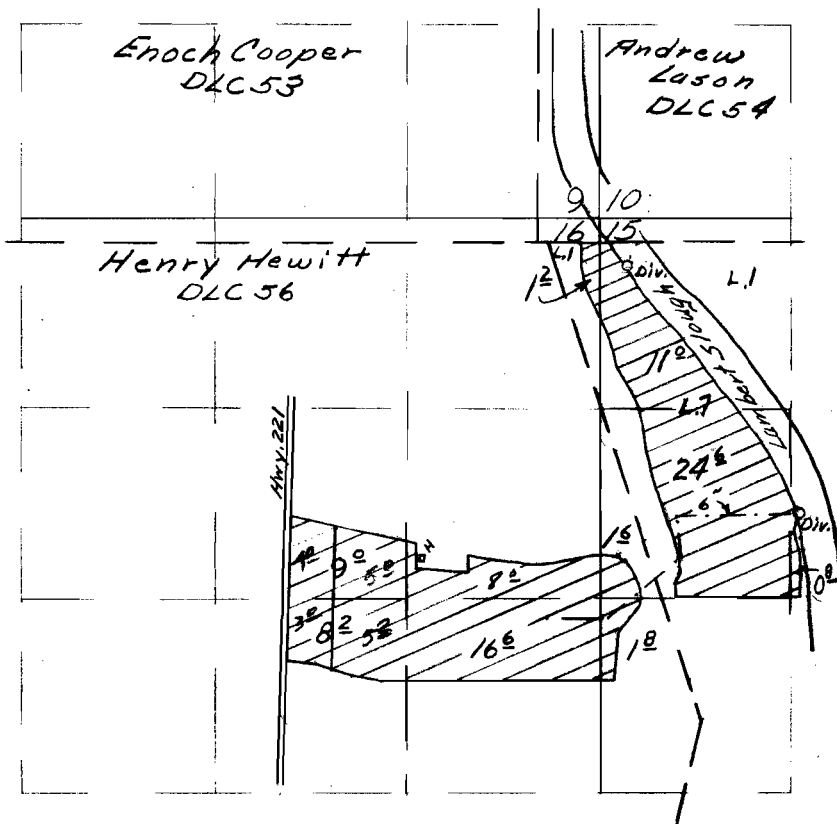

FINAL PROOF SURVEY
UNDER

Application No 25717 Permit No 20142
IN NAME OF

C. M. Boulden

Surveyed May 26 1955, by T. Jones