


T. 4S. R. 1E. W.M.

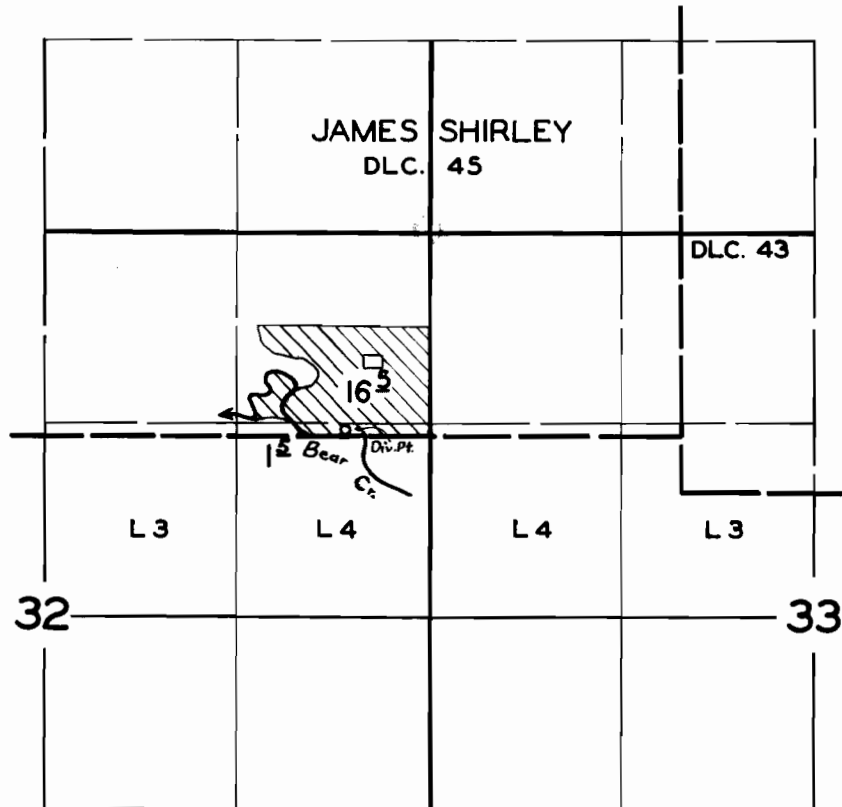

**FINAL PROOF SURVEY**

UNDER

Application No. 25757 Permit No. 20153

IN NAME OF

**JOHN L. & EVELYN M. PATTERSON**

Surveyed 7 MAR. 1956, by R. D. BEST

DFK-3D-47

*Rest*