


T.22S. R.6W.W.M.

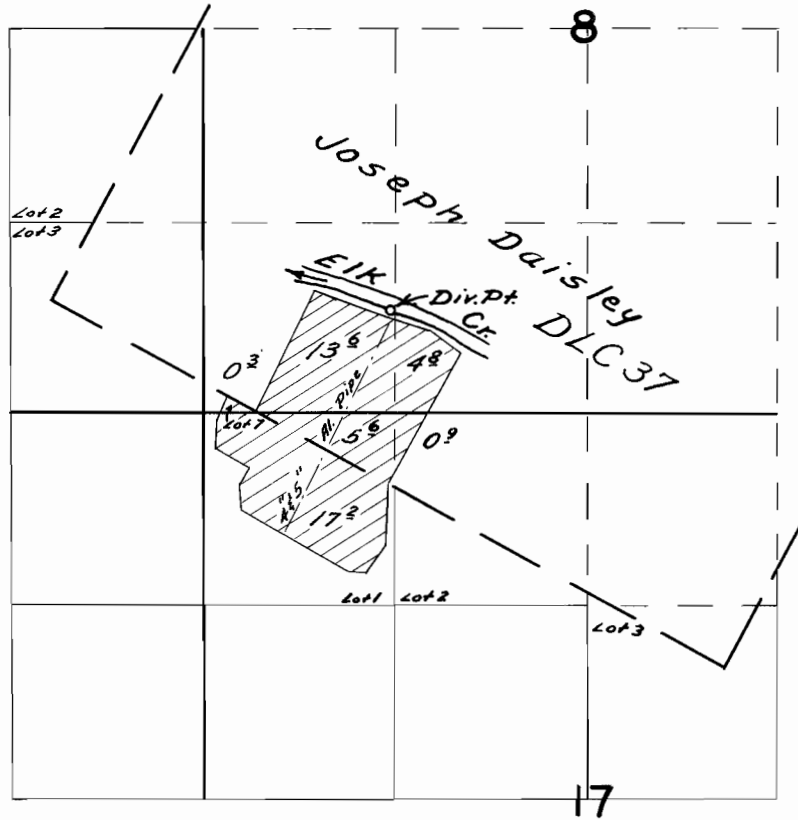

FINAL PROOF SURVEY

UNDER

Application No. 25779 Permit No. 20160
IN NAME OF

Ray R. Miller

Surveyed June 28 1956, by C.O. Bartels