


T. 5S. R. 1W. W.M.

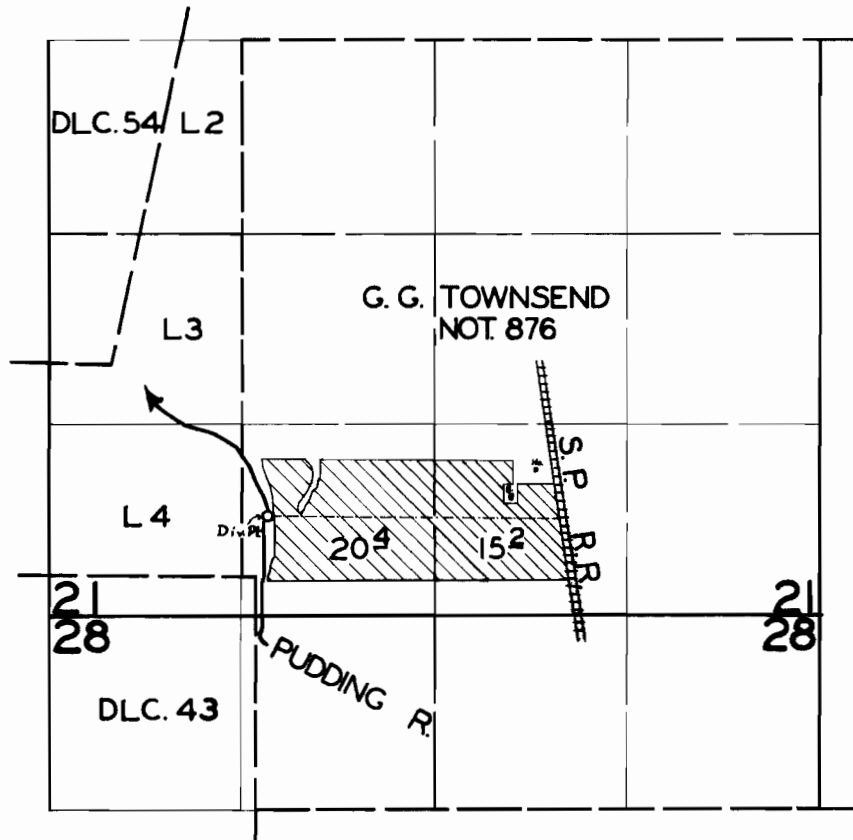

FINAL PROOF SURVEY
UNDER

Application No. **25433** Permit No. **20217**
IN NAME OF

CLIFFORD HALKINRUD

Surveyed **29 FEB. 1956**, by **R. D. BEST**

DFN-2D-207

RLB