


T.5S.R.IW.W.M.

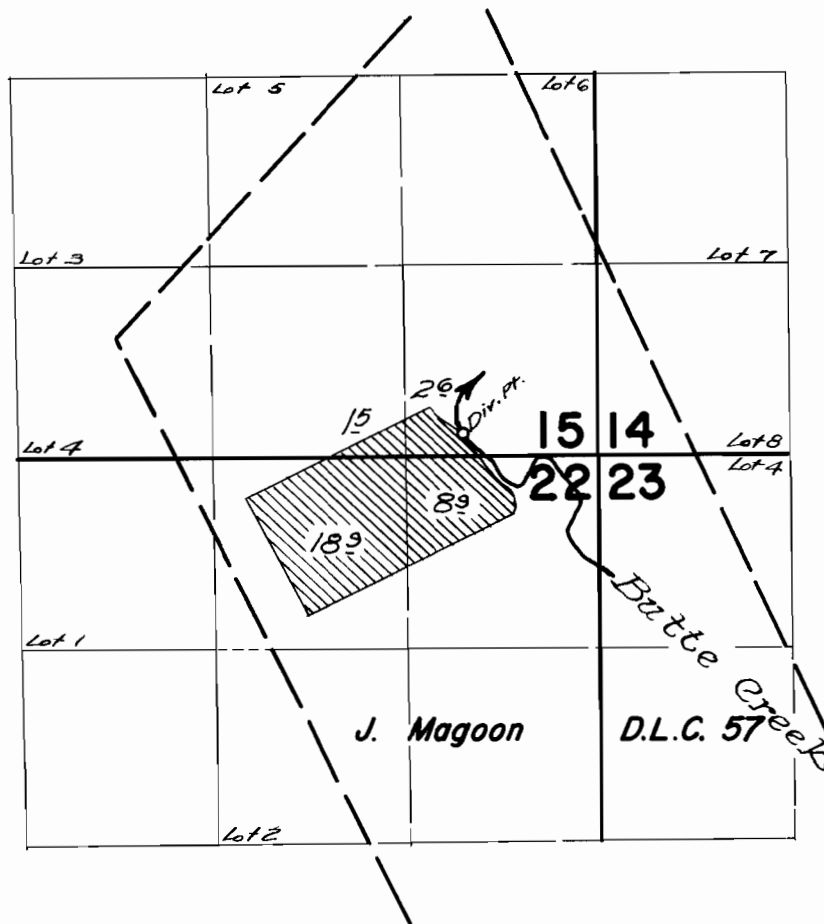

FINAL PROOF SURVEY UNDER

Application No. **25591** Permit No. **20226**
IN NAME OF

FLORENCE NANCY LUCAS

Surveyed *Sept. 7 1956*, by *M. Bish.*

AK