


T. 6 S. R. 1 W. W. M.

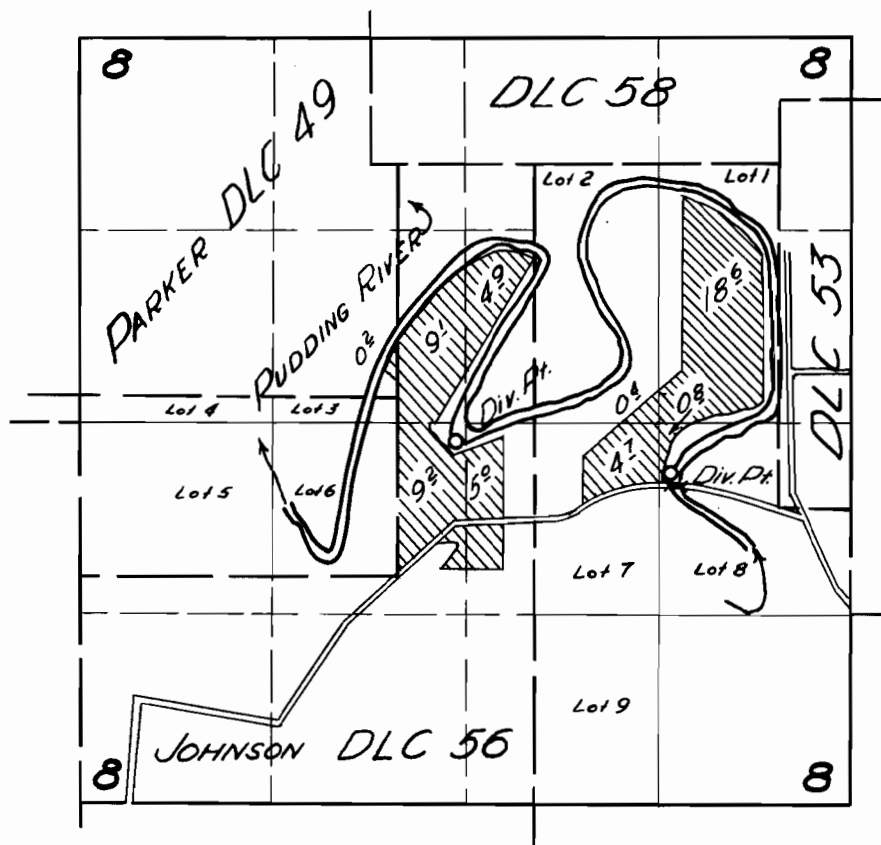

FINAL PROOF SURVEY
UNDER

Application No. 25718 Permit No. 20256
IN NAME OF

E. G. & LULU C. WIESNER

Surveyed 30 Mar 1956 by [Signature]