


T.5 S. R.1 W.W.M.

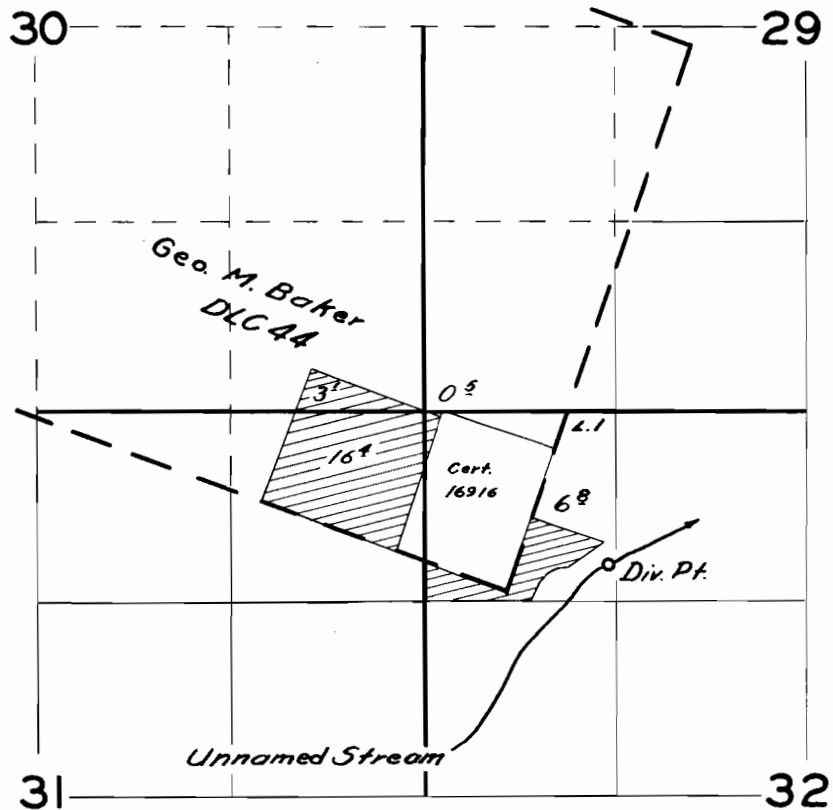

FINAL PROOF SURVEY

UNDER

Application No. 25753 Permit No. 20266

IN NAME OF

Joseph G. Smith

Surveyed May 31, 1956, by C. O. Bartels