


T. 10S. R. 4 W.W.M.

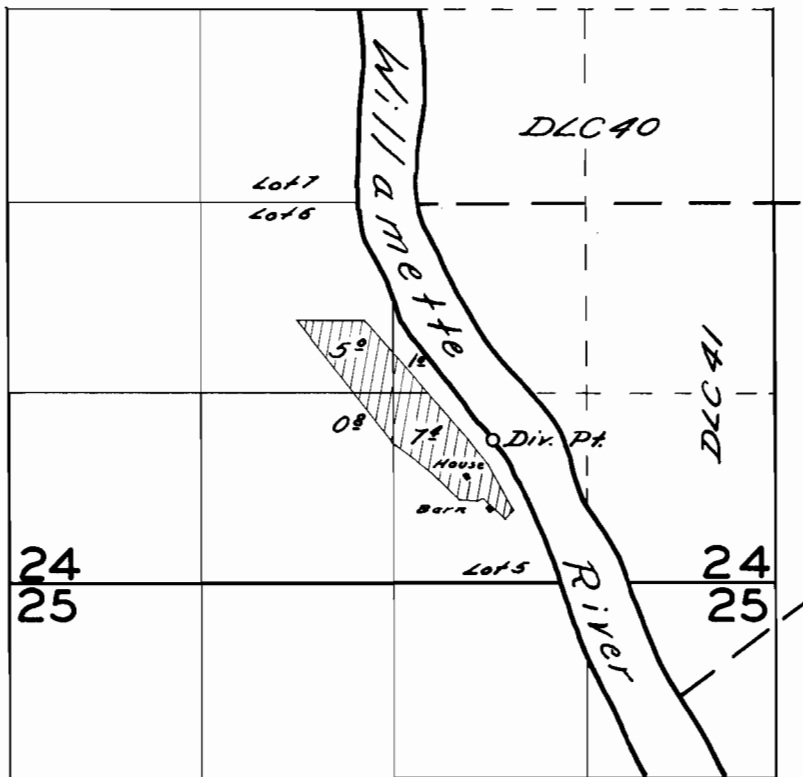

FINAL PROOF SURVEY
UNDER

Application No. 25796 Permit No. 20279
IN NAME OF

Neil G. & Wilma M. Allen

Surveyed Sept. 6 1956, by C. O. Bartels