


T.22 S. R.7W.W.M.

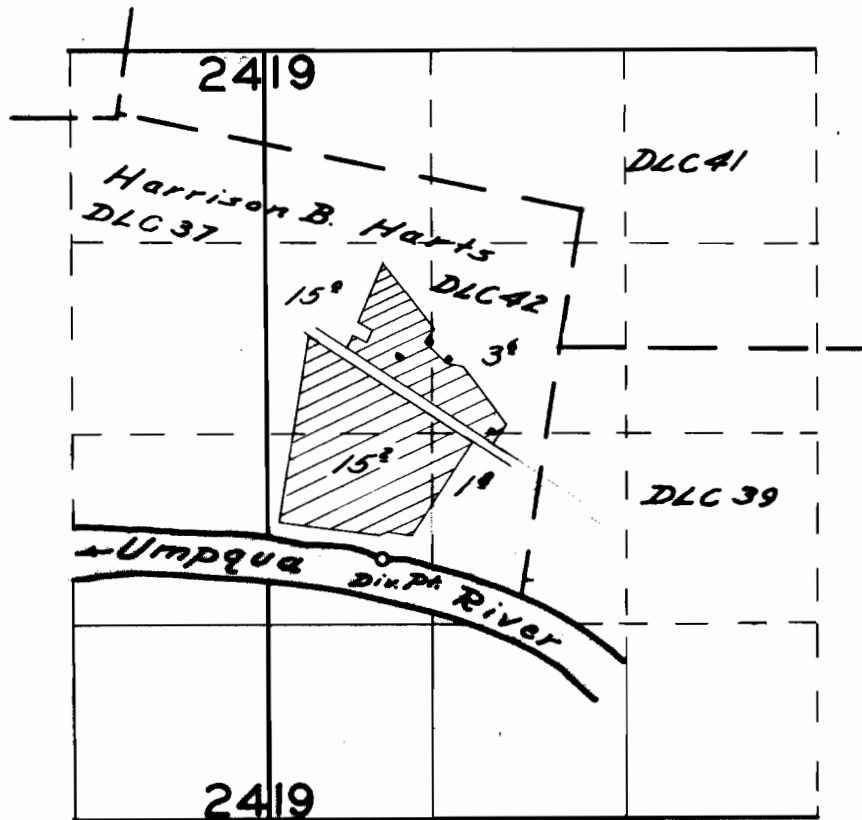

**FINAL PROOF SURVEY**

UNDER

Application No. 25921 Permit No. 20332

IN NAME OF

Oliver Haines

Surveyed July 11, 1956, by C.O. Bartels