


T.27S. R.4W.W.M.

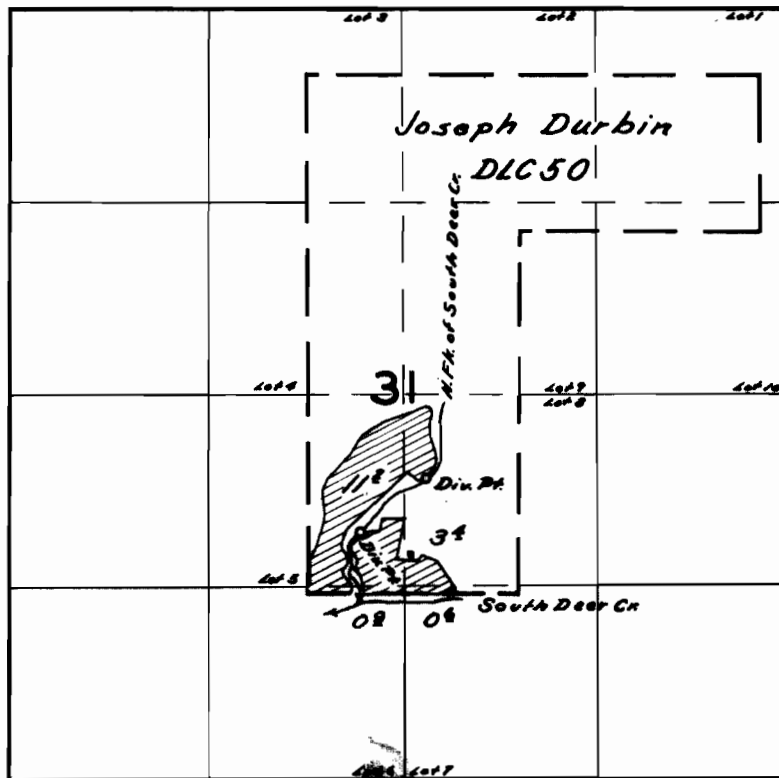

**FINAL PROOF SURVEY**  
UNDER

Application No. ~~25934~~ Permit No. ~~20339~~  
IN NAME OF

*R.V. Hatfield*

Surveyed *June 12* 1956, by *C.O. Bartels*