


T. 4 S. R. 1 W. W. M.

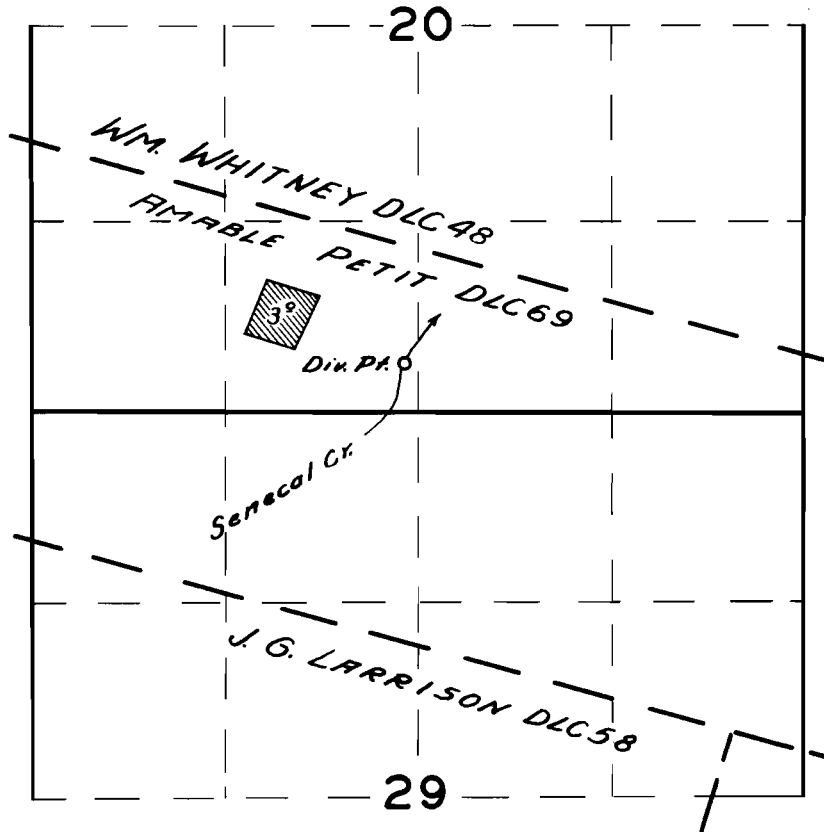

FINAL PROOF SURVEY

UNDER

Application No. 25254 Permit No. 20348

IN NAME OF

JOHN H. MILLER

Surveyed June 21, 1956, by C.O. Bartels