


T.5N. R.7W. W.M.

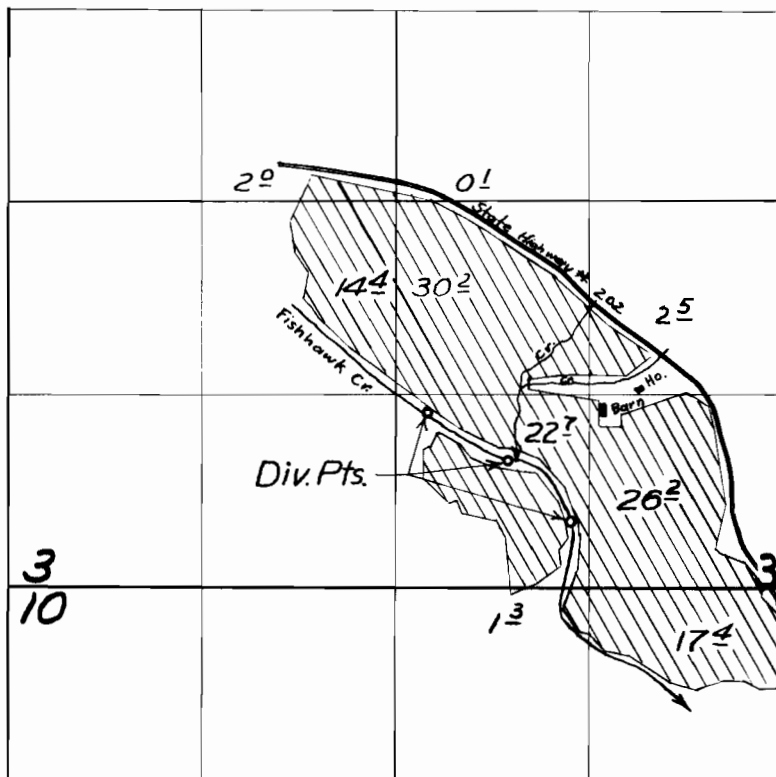

FINAL PROOF SURVEY

UNDER

Application No. 26044 Permit No. 20385

IN NAME OF

Glen F. Engbretson

Surveyed 14 Aug 1956, by Tom Bieh